

SUMNER


Form 51-5M-3-35-Mid-West

Map No. KANSAS Sec. 13 Twp. 34 R. 2-W

Well No. 1-Hess Farm

Wilcox et al Company

NORTH

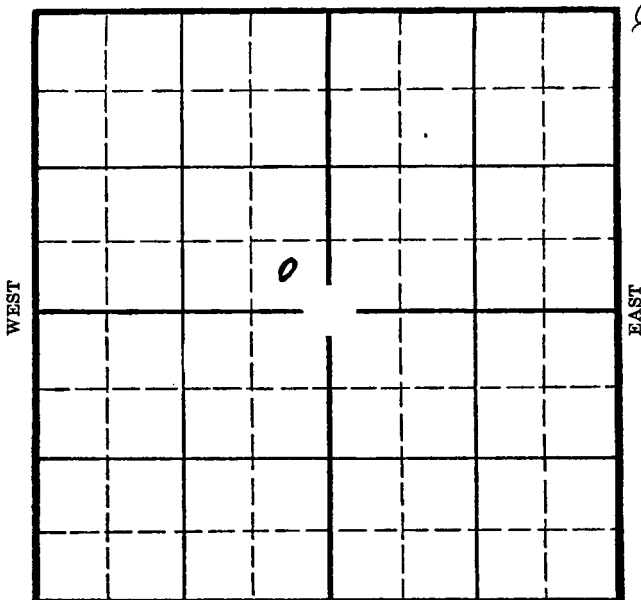

SOUTH

Location

Drilling Remarks

Rig Up

Drilling Remarks

RECORD

Cased in. ft.

Sand

Gas

Oil

Total Depth

PRODUCTION

1st 24 hrs. Nat.

1st 24 hrs. after shot

Gas cu. ft.

Dry Hole

Abandoned

Map No. _____ Sec. 13 Twp. 34 R. 2W
Well No. 1-155 Farm _____
Wilcox et al Company _____


_____ Ft. from N. Line

330 Ft. from S. Line

330 Ft. from E. Line

_____ Ft. from W. Line

Elev. 1168

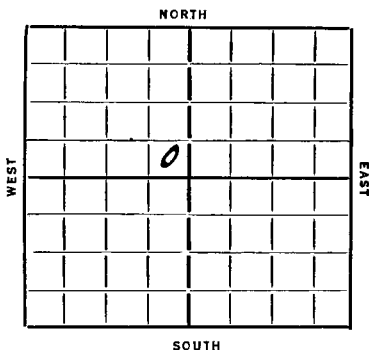

REPORT

7/36 Location
2/4 B.R.
5/20 --
3/27 Drlg. 186'
4/2 15"- 134' Drlg. 335'
4/10 Drlg. 1900'
4/16 Drlg. 2923'
1/23 Drlg. 3521' 4581
1/30 Drlg. 3896' 1168
5/7 Chat 4120' Drlg. 4174'.
5/14 --Drlg. 4224'.
1/21 B.L. 4380'. Drlg. 4451'.
5/28 Viola 4581'. Wilcox **4584'**. Drlg. **4590'**.
6/3/36 - Wilcox 4584'.
T.D. 4605'.
D & A
ABANDONED

Map No. 31 Sec. 13 Twp. 34 R. 2 nWell No. 1- HessWilcox et al Company

Contractor

SECTION PLAT

	0		

Ft. from N. Line

330 Ft. from S. Line330 Ft. from E. Line

Ft. from W. Line

Location ☒

Rig up

Drilling and Remarks:

RECORD

Cased in., ft.

Sand

Gas

Oil

Total Depth

PRODUCTION

1st 24 hrs. Nat.

1st 24 hrs. after shot

Gas Cu. Ft.

Dry Hole

Abandoned

Date

3-4-36 192 Scout

KANSAS

Map No. 31 Sec. 18 Twp. 24 R. 2WWell No. 1 Hess.Wilcox Oil & Gas Company

Contractor

SECTION PLAT

_____ Ft. from N. Line

330 Ft. from S. Line330 Ft. from E. Line

_____ Ft. from W. Line

ABANDONED

Location _____

Rig up _____

Drilling and Remarks:

Wilcox 4584NA

RECORD

Cased _____ in., _____ ft.

Sand _____

Gas _____

Oil _____

Total Depth 4605

PRODUCTION

1st 24 hrs. Nat. _____

1st 24 hrs. after shot _____

Gas _____ Cu. Ft.

Dry Hole _____

Abandoned _____

Date

JUN 2 1932 19

S. J. LEWIS

Scout