


Section 13 Township 34 Range 15WWell No. #1 Davis RanchCompany M. B. Armer

NORTH

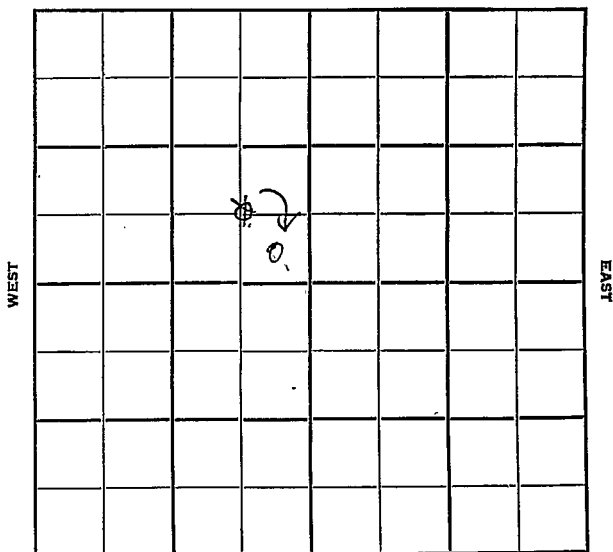

SOUTH

Barber

KANSAS

Sec. 13 Twp. 34 R. 15W

Well No. #1 Davis Ranch Farm

M. B. Armer Company

Mid-American - Contr. Contractor

Wildcat

Ft. from N. Line

330
660


Ft. from S. Line

330
660


Ft. from E. Line

Ft. from W. Line

SE SE NW
C SE NW

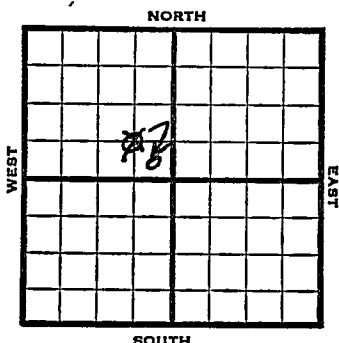

1952	Elev. 1709'	REPORT
6/25	Spud 6-23-52 8" @ 360 WOC	
7/2	Drlg. 2670'	
7/9	Drlg. 4110'	
7/17	Drlg. 4730'	
7/23	Miss. 4839 5" @ 4854'	TD 4860
7/30	NR	
8/6	WOCT Schl Tops: Heeb. 4016 Br Li 4215 KC 4226 Miss 4839 RTD 4860	
8/13	NR	
8/20	"	
8/27	"	
9/3	"	
9/10	"	
9/17	"	
9/24	"	
10/1	Spud 6-23-52 Shut in gas well TD 4875 8" @ 360' Miss. 4839 TD 4860 5" @ 4854' Heeb. 4016 Br Li 4215 KC 4226 Miss. 4839 DD 4875 1000 A 24/ 4840-48 2 mcfg & SSD Comp. shut in gas well	
COMPLETED		

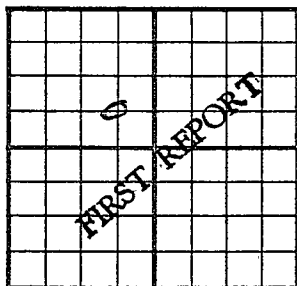
County Barber State KansasSec. 13 (Blk.) 34 (Sur.) 15E Map No.
(Twp.)Operator M. B. ArmerWell No. 1 Farm Davis RanchElev. _____ Location C SE NW660 Ft. From S Line NW660 Ft. From E Line _____ Quarter1st. Report JUN 25 1952

Completion _____

Remarks _____

Mid-American - Contr.Spudding Date 6-23-52Drlg. Data Wildcat8" @ 360 WOCJ. G. McGEHEE

County Barber State Kansas
 Sec. 13 (Blk. Twp.) 34 (Sur. Rge.) 15W Map No.
 Operator M. B. Armer
 Well No. 1 Farm Davis Ranch
 Elev. 1709 Location SE SE NW

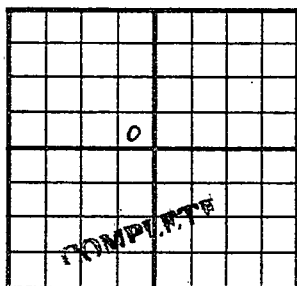

330 Ft. From S Line NW
330 Ft. From E Line Quarter

1st. Report

Completion OCT 1 1952

Remarks Wildcat

Mid-American - Contr.

Spudding Date 6-23-52

Drlg. Data Shut in gas well TD 4875

8" @ 360 Miss. 4839 TD 4860

5" @ 4854 Heeb. 4016. Br. lime 4215

KC 4226 Miss. 4839 DD 4875 1000 A

24/ 4840-48 2 mcfg & SSO

Comp. shut in gas well

Kansas

Map No. _____ Sec. 13 Twp. 34 R. 15W

Well No. 1 Davis Ranch

M. B. Armer _____ Company

CORRECTION _____ Contractor

SE SE NW

SECTION PLAT

_____ Ft. from N. Line

330 Ft. from S. Line

330 Ft. from E. Line

_____ Ft. from W. Line

Barber County

Location _____

Rig up _____

Drilling and Remarks:

Reported

C SE NW

RECORD

Cased _____ in., _____ ft.

Sand _____

Gas _____

Oil _____

Total Depth _____

PRODUCTION

1st 24 hrs. Nat. _____

1st 24 hrs. after shot _____

Gas _____ Cu. Ft.

Dry Hole _____

Abandoned _____

Date

Jul 7 1952 19

G. McGEHEE

Scout