


Seward

KANSAS

SECTION 13 TOWNSHIP 34S RANGE 33W

WELL NO. #1-13 Eubank

COMPANY Panhandle Eastern

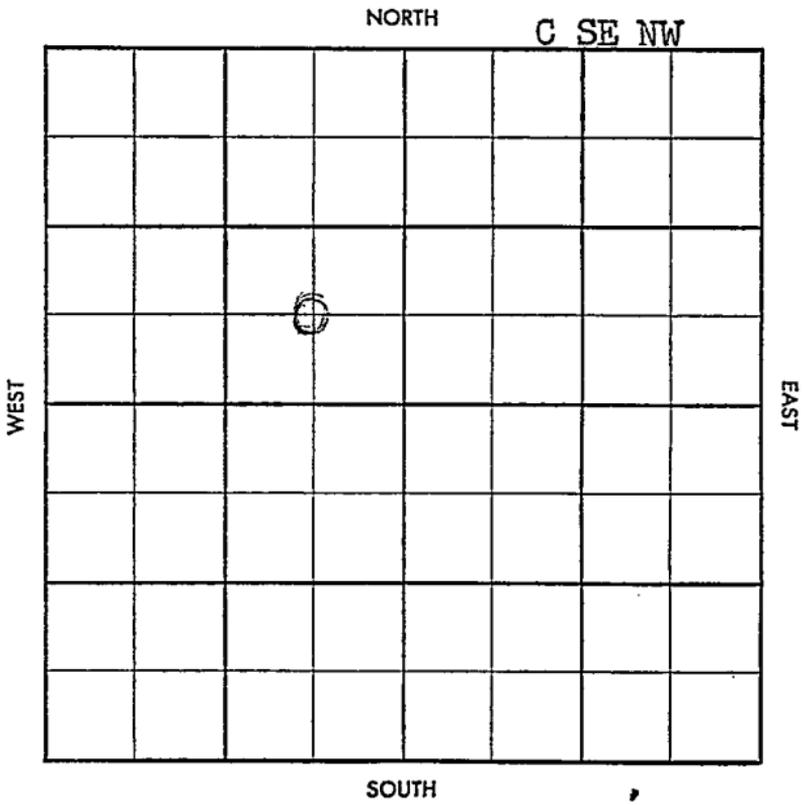

Top 116 Foot No
 Bottom 110 Foot No

S-513-B

County Seward Elev 28320-8-5RB
 Sec. 13 Twp. 34 Rge. 33W
 Company Panhandle Eastern
 Farm Name Eubank No. 1-13

TOPS	DEPTH'	LOG	DATUM
Anh. <u>H01</u>	<u>2574</u>		
Tp. <u>Her</u>	<u>2619</u>	<u>2634</u>	
H. <u>Krid</u>	<u>2647</u>	<u>2661</u>	
Tr.			
Dg.			
B.L.			
L.			
K.C.			
B.K.C.			
Ce.			
C.			
M.			
M.			
K.			
Mz.			
Mq.			
V.			
S.			
S.			
A.			
R.			
Pf.			
G.			
T.D.	<u>2740</u>		

Loc. in Sec. C SE NW
 Geol. _____
 Contr. _____
 Pool Hugoton

COMPLETE	
0	
SEP 3 '58	

Date Comm. 6-15-58
7" @ 670/225 WOC JUN 25 '58 4" 2735/125
JUL 2 '58 @ 2689 26/2669-82
29/2636-50 (2) \$ 5g wph sgaa
frac 4 X 2 ga 1.377 mcf + LD
 Tbg wot JUL 9 '58 JUL 16 '58 JUL 23 '58 JUL 30 '58
 AUG 6 '58 AUG 13 '58 AUG 20 '58 AUG 27 '58 SEP 3 '58
00 P10 1.377 MCF

⌘

Co.
 Lse.
 No.
 Sec.
 T.
 R.