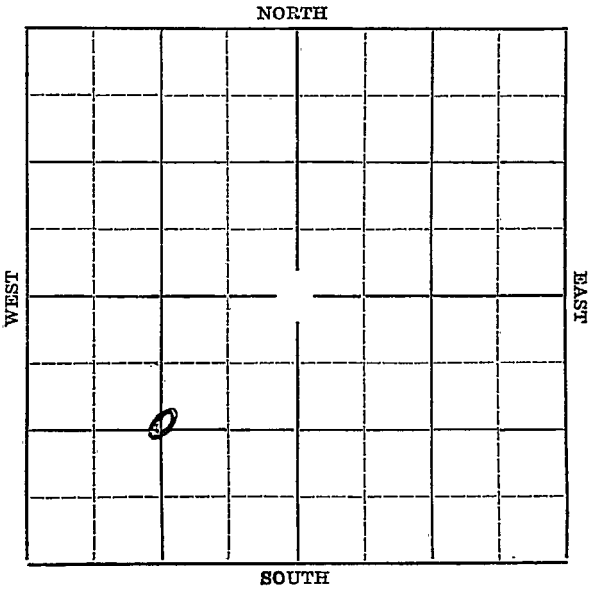
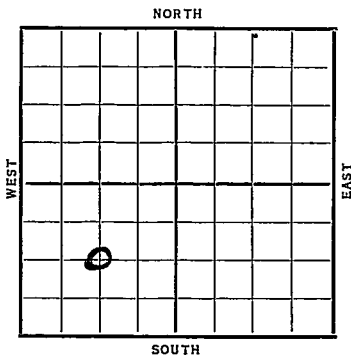


Section 13 Township 34 Range 38-WWell Number #1 FinchCompany Stevens O & G

Well No. #1 Finch Farm
Stevens O & G Company

1320' Ft. from W. Line

[illegible]

KANSASMap No. X Sec. 13 Twp. 24 R. 38WWell No. 1 FinchStevens Oil & G Company

Contractor

SECTION PLAT

_____ Ft. from N. Line

1320 Ft. from S. Line

_____ Ft. from E. Line

1320 Ft. from W. Line**FIRST REPORT**Location ✓

Rig up _____

Drilling and Remarks:

RECORD

Cased _____ in., _____ ft.

Sand _____

Gas _____

Oil _____

Total Depth _____

PRODUCTION

1st 24 hrs. Nat. _____

1st 24 hrs. after shot _____

Gas _____ Cu. Ft.

Dry Hole _____

Abandoned _____

Date

OCT 21 1933 19S. J. LEWIS


Scout

KANSAS

Map No. No Map Sec. 13 Twp. 34 R. 38WWell No. 1 FinchStevens O & G Company

Contractor

SECTION PLAT

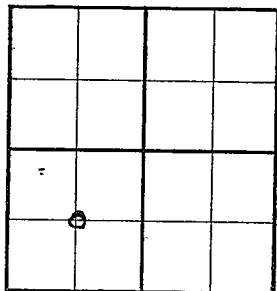

____ Ft. from N. Line

1220 Ft. from S. Line

____ Ft. from E. Line

1320 Ft. from W. Line

COMPLETED

Location _____

Rig up _____

Drilling and Remarks:

Gas Sand 26056 3/5 M Gas.

RECORD

Cased _____ in., _____ ft.

Sand _____

Gas _____

Oil _____

Total Depth 2835

PRODUCTION

1st 24 hrs. Nat. _____

1st 24 hrs. after shot _____

Gas _____ Cu. Ft.

Dry Hole _____

Abandoned _____

Date

DEC 16 1936

19

S. J. LEWIS

Scout