


Morton

KANSAS

SECTION 13 TOWNSHIP 34S RANGE 42W

WELL NO. #1 German

COMPANY Panhandle Eastern

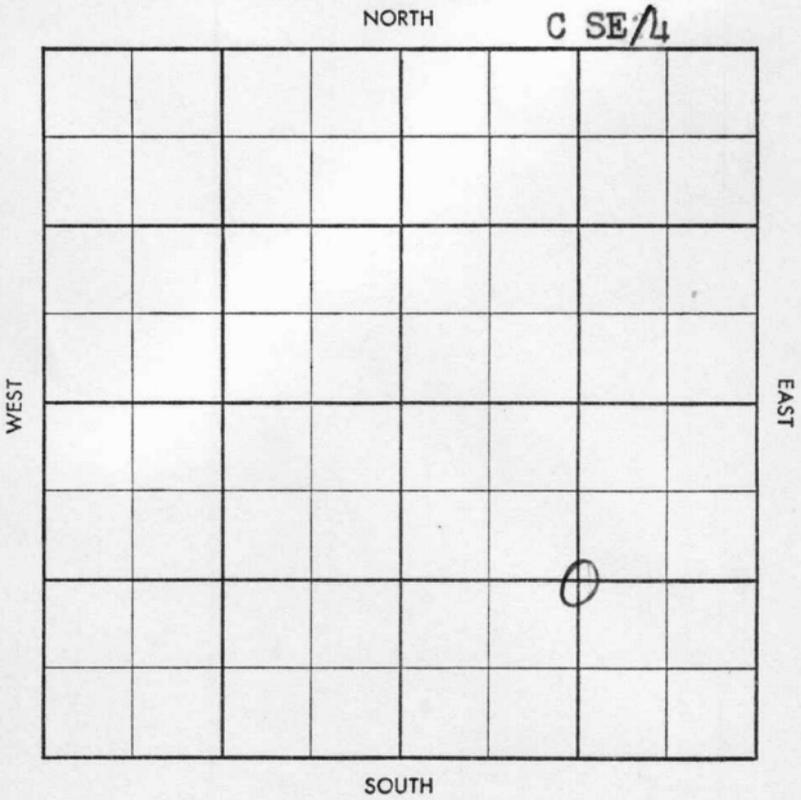

~~12-1-39~~
~~12-1-39~~ 20

County Morton Elev. _____
Sec. 13 Twp. 34 Rge. 42W
Company Panhandle Eastern
Farm Name German No. 1


TOPS	DEPTH	LOG	DATUM
Anh.			
Tp.			
H.			
Tr.			
Dg.			
B.L.			
L.			
K.C.			
B.K.C.			
Ce.			
C.			
M.			
M.			
K.			
Mz.			
Mq.			
V.			
S.			
S.			
A.			
R.			
Pf.			
G.			
T.D.			

Loc. in Sec. _____
C SE/4
Geol. _____
Contr. _____
Pool _____
Greenwood



Date Comm. _____
Location

Co.
Lse.
No.
Sec.
T.
R.

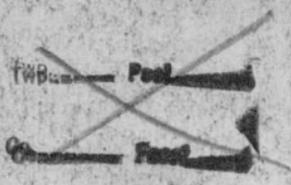

5-513-B

County Morton Elev. 34600' 34710'
 Sec. 13 Twp. 34 Rge. 42W
 Company Panhandle Eastern
 Farm Name German No. 1-13

TOPS	DEPTH	LOG	DATUM
Anh. <u>W 26</u>		<u>2733</u>	
Tr.		<u>2954</u>	
Dg.		<u>3221</u>	
B.L.			
L.			
K.C.			
B.K.C.			
Ce.			
C.			
M.			
M.			
K.			
Mz.			
Mq.			
V.			
S.			
S.			
A.			
R.			
Pf.			
G.			
T.D.	<u>3295</u>		

Loc. in Sec. C SE/4

Geol. _____
 Contr. _____

Pool Greenwood



Date Comm. 4-23-58
 Location APR 23 '58 APR 30 '58 2500 MAY 7 '58

7" 654/300 Log 4" 3288/150
MICT MAY 14 '58 CO 3244 18/ 3195-3204

1 ga 1.000 mg 10/ 3160-65
10/ 3149-54 12/ 3134-40 60/ 3084

- 3114 18/ 3029-30 12/ 3011-17
18/ 2993-3002 8) ga 9.050 mg

kn 769 MAY 21 '58 MAY 28 '58 JUN 3 '58 JUN 11 '58
JUN 18 '58 JUN 25 '58 JUL 2 '58 JUL 9 '58 JUL 16 '58
JUL 23 '58 JUL 30 '58 AUG 6 '58 AUG 13 '58 AUG 20 '58

AUG 27 '58

13 58

SEP 10 '58

delivered 3.294 MCF RP 395

13-34-42W

CSE/4