

Morton

KANSAS

SECTION 13 TOWNSHIP 34 S RANGE 42W

WELL NO. #1 U.S.A.


COMPANY Kerby Drlg. Co.

NORTH

C SW/4

WEST

EAST

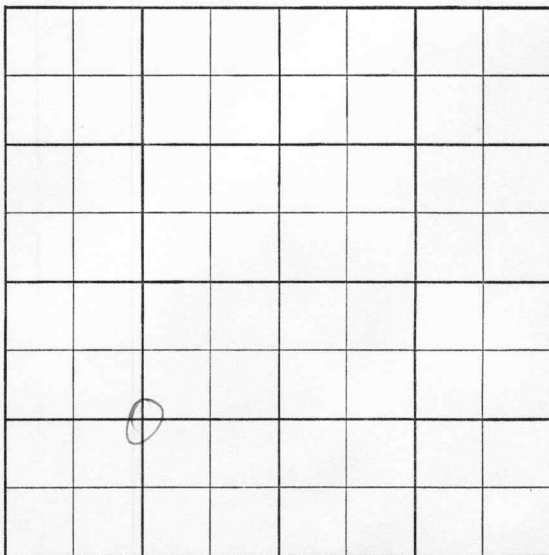

SOUTH

20

CO. Morton ELEV. _____SEC. 13 TWP. 34 RGE. 42NCOMPANY Kerby Drlg. Co. NO. 1

JAN 15 '58

FIRST REPORT

FARM U. S. A.LOC. C SW/4

GEOL. _____

CONTR. _____

POOL Greenwood

SPUD _____

Location _____

CO.

LSE.

NO.

SEC.

TWP.

RGE.

