

Geological Survey

WICHITA BRANCH  
KANSAS DRILLERS LOG

IMPORTANT  
Kans. Geo. Survey request  
samples on this well.

15-007-20594  
32-34-14W

S. 32 T. 34 R. 14 E  
W

API No. 15 — 007 — 20,594  
County Number

Loc. C E2 SW

Operator  
Graham-Michaelis Corp.

County Barber

Address  
P. O. Box 247 Wichita, Kansas 67201


Well No. #5  
Lease Name Farley

Footage Location 100' W of E 1/2 SW 1/4 or  
1320 feet from (S) line 760 feet from (E) line SW 1/4

Principal Contractor Red Tiger Drilling Co.  
Geologist Don F. Moore

Spud Date February 11, 1978  
Total Depth 4855' P.B.T.D.

Date Completed February 22, 1978  
Oil Purchaser none

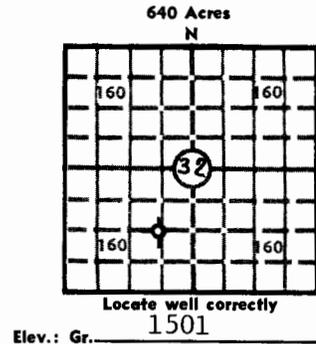

DF 1504 KB 1506

CASING RECORD

Report of all strings set — surface, intermediate, production, etc.

Purpose of string	Size hole drilled	Size casing set (in O.D.)	Weight lbs/ft.	Setting depth	Type cement	Sacks	Type and percent additives
To protect fresh water supply	12 1/4"	8 5/8"	23#	894'	common	475	2% gel 3% cal chl.

LINER RECORD

PERFORATION RECORD

Top, ft.	Bottom, ft.	Sacks cement	Shots per ft.	Size & type	Depth interval
TUBING RECORD			NONE		
Size	Setting depth	Packer set at			
NONE					

ACID, FRACTURE, SHOT, CEMENT SQUEEZE RECORD

Amount and kind of material used	Depth interval treated
NONE	

INITIAL PRODUCTION

Date of first production	NONE	Producing method (flowing, pumping, gas lift, etc.)	D&A
RATE OF PRODUCTION PER 24 HOURS	Oil	Gas	Water
	bbls.	MCF	bbls.
Disposition of gas (vented, used on lease or sold)	Producing interval(s) NONE		

INSTRUCTIONS: As provided in KCC Rule 82-2-125, within 90 days after completion of a well, one completed copy of this Drillers Log shall be transmitted to the State Geological Survey of Kansas, 4150 Monroe Street, Wichita, Kansas 67209. Copies of this form are available from the Conservation Division, State Corporation Commission, 3830 So. Meridian (P.O. Box 17027), Wichita, Kansas 66217. Phone AC 316-522-2206. If confidential custody is desired, please note Rule 82-2-125. Drillers Logs will be on open file in the Oil and Gas Division, State Geological Survey of Kansas, Lawrence, Kansas 66044.

Operator GRAHAM-MICHAELIS CORPORATION DESIGNATE TYPE OF COMP.: OIL, GAS, DRY HOLE, SWDW, ETC.: DRY HOLE

Well No. 5 Lease Name FARLEY

S 32 T 34 R 14 W 100' W of E 1/2 SW 1/4; Barber Co. Kansas

**WELL LOG**

Show all important zones of porosity and contents thereof; cored intervals, and all drill-stem tests, including depth interval tested, cushion used, time tool open, flowing and shut-in pressures, and recoveries.

SHOW GEOLOGICAL MARKERS, LOGS RUN, OR OTHER DESCRIPTIVE INFORMATION.

FORMATION DESCRIPTION, CONTENTS, ETC.	TOP	BOTTOM	NAME	DEPTH
Surface Soil	0	223	Petro-Log - Radiation Guard	
Red Bed	223	297		
Red Bed and Sand Streaks	297	314		
Red Bed	314	374		
Red Bed and Sand Streaks	374	630		
Red Bed	630	1407		
Shale & Red Bed	1407	1529		
Anhydrite/Shale	1529	1546		
Shale/Lime	1546	1721		
Shale	1721	1765		
Lime	1765	2835		
Lime & Shale	2835	3312		
Lime	3312	3480		
Lime & Shale	3480	3928		
Lime	3928	4800		
Chert & Lime	4800	4855		
RTD		4855'		
<p>DRILL STEM TEST #1            4768-4800            Open 30", shut in 45", open 60", shut in 45"            Recovered: 90' of mud            IFP: 39-39#            ISIP: 79#            FFP: 39-39#            FSIP: 92#</p>				

USE ADDITIONAL SHEETS, IF NECESSARY, TO COMPLETE WELL RECORD.

Date Received \_\_\_\_\_

  
 Signature  
 Geological Secretary  
 Title  
 February 28, 1978  
 Date