

2. Truston, Cal. Company

NORTH

WEST

EAST

SOUTH

Location_____

Drilling Remarks

Rig Up_____

Drilling Remarks

RECORD

Cased _____ in. _____ ft.

Sand _____

Gas _____

Oil_____

Total Depth

PRODUCTION

1st 24 hrs. Nat.

1st 24 hrs. after shot


Gas cu. ft.

Dry Hole _____

Abandoned.....

Map No. KANSAS Sec. 14 Twp. 34 R. 12W
 Well No. 1-204 Farm
C. Austin et al Company

NORTH

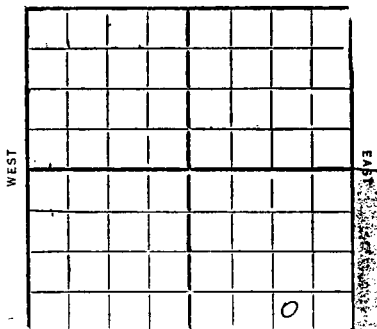

Ft. from N. Line

330 Ft. from S. Line

990 Ft. from E. Line

Ft. from W. Line

932 Our lease - SW 1/4 Sec 13-34-12W

SOUTH

Date

REPORT

1159
M. M.
7/13 Bedg rig
7/20 Rough up
7/27 20"-63
8/3 Drilg 300'
3/10 15"-298
Drilg 950'
3/17 12 1/2"-1140
Drilg 1550'
3/24 10"-1673
HFV 1970-80
Drilg 2420'
3/31 10"-2035
Drilg 2420'
1.7 3 Failur water 2.00
2.2500' - 10"
7/14 10"-2507
Drilg 2630'
12/1 8"-2785
HFV 2850
2926 11/10 8 1/4"

9/30- 1 8"-2930

2 and 3215-3300

Drill ahead.

10/5- Drill 3560

10/12- Land 3725-60

HFW 3740-45

TD 3760' UIR 6"

10/19- UIR 6"- 3815'

10/26- Top chat 3950

5"-3883

Oil show 3965-75 in core.

TD 3975

700' fluid in hole

show 10 to 12 lbs.

oil & same amount water

Well clean

11/2- drill 4063' lime

11/9- " 4235 "

11/16- Base lime 4225

5"-4230

On Welcox 4303

HFW 4319

TD 4348

Will plug back

11/23- Welcox 4503-4'8"

HFW 4319

TD 4348

Abandoned

Summer

31 Map No. Sec. 14 Twp. 34 R. 1 W

Well No. 1 Key
A. Austin et al Company

Contractor

SECTION PLAT

			0

Ft. from N. Line

330 Ft. from S. Line

990 Ft. from E. Line

Ft. from W. Line

Location

Rig up

Drilling and Remarks:

HFW 4319

RECORD

Cased in., ft.

Sand 4303-4348

Gas

Oil

Total Depth 4348

PRODUCTION

1st 24 hrs. Nat.

1st 24 hrs. after shot

Gas Cu. Ft.

Dry Hole ✓

Abandoned ✓

Date

1932

192


Scout

31 **KANSAS** *W/*
 Map No. _____ Sec. *14* Twp. *34* R. *1*
 Well No. *1* *For*
H. Austin *Oil* Company

Contractor _____

FIRST REPORTS

SECTION PLAT

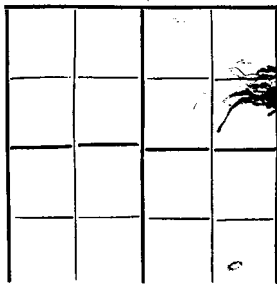

_____ Ft. from N. Line

330 _____ Ft. from S. Line*990* _____ Ft. from E. Line

_____ Ft. from W. Line

Over lease
SW 1/4 Sec. 13.

Location _____

Rig up _____

Drilling and Remarks:

Moving in material

RECORD

Cased _____ in., _____ ft.

Sand _____

Gas _____

Oil _____

Total Depth _____

PRODUCTION

1st 24 hrs. Nat. _____

1st 24 hrs. after shot _____

Gas _____ Cu. Ft.

Dry Hole _____

Abandoned _____

Date

JUL 1 6 1892

CHAS L. SHERWOOD

192

Scout