


DX 78-1

Clark KANSAS ✓

Section 14 Township 34 Range 21W

Well No. 1 J. C. Harper "B"

Company Pure Oil

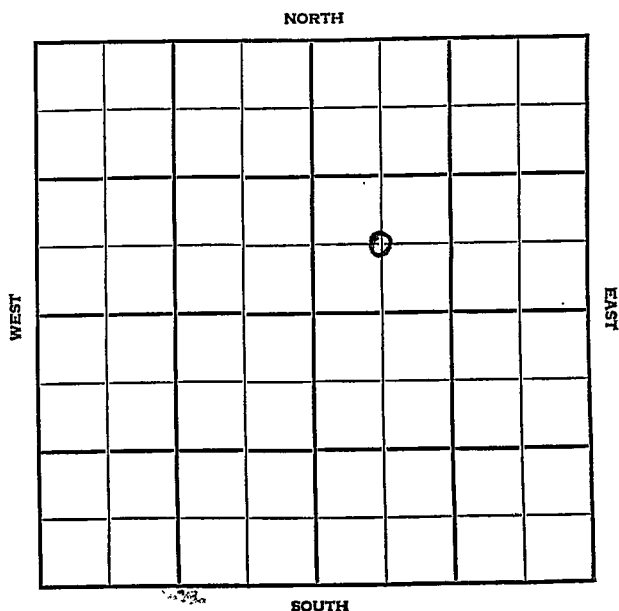

Clark

KANSAS

SEC.	TWP.	R.
14	34	21W

WELL NO.

#1 J.C. Harper "B"

FARM

COMPANY

Pure Oil

CONTRACTOR

Unit Drlg.

Harper Ranch Pool

NORTH

Ft. from N. Line


660

Ft. from S. Line

Ft. from E. Line

660

Ft. from W. Line

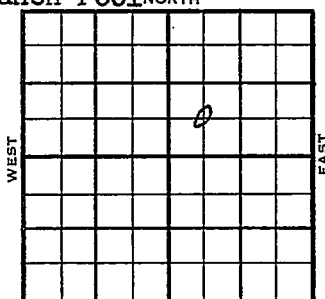

SOUTH

C SW NE

	ELEVATION	REPORT
1955	1824'	
3/23	Spud 3-20-55 TD 76' Rng. 16"	5535 1824 3711
8/3	16" @ 80/150 10 3/4" @ 573/350 DST 5408-54 open 45 min. Rec 750' sg cm 1618/15" DST 5452-5535 open 1 hr Rec. 180' mud 1105' muddy sw 1960/15" 5 1/2" @ 5527 CO to 5509 96/5429-53, frac sq perf. CO to 5484 10/5448-53 10/ 5435/40 500A frac S/72 bo 120 bsw S/70 bw 20 hr. 1/5435 1/5440 1/5450 1/5456 200A frac F/5 bo 1 hr. S/94 bo 194 bw 24 hr. D&A Anh: 2195 371 L. 4489 4487 2663 CeMorrow 5374 5372 3548 C. 1st sd = 5406 3582 M. an ds 5431 3607 M. Upper 5510 5510 3688 TD. 5535	

ABANDONED

FABEN GILSTRAP

MAR 28 1955

Card

to Mr. [unclear]

from Mr. [unclear]

Subject: [unclear]

33

Orig. Date

County Clark Elev. 1824
 Sec. 14 Twp. 34 Rge. 21W
 Company Pure Oil
 Farm Name J. C. Harper "B" No. 1

TOPS	DEPTH	LOG	DATUM	Loc. in Sec.
Anh.	<u>2195</u>		<u>371</u>	<u>C SW NE</u>
Tr.				
H.				
Tr.				
Dg.				
Bl.				
L.	<u>4489</u>	<u>4487</u>	<u>2663</u>	Geol.
K.C.				
B.K.C.				Contr.
Ce. <u>Morrow</u>	<u>5374</u>	<u>5372</u>	<u>2548</u>	<u>United Drilg.</u>
C. <u>1st sd</u>		<u>5406</u>	<u>3582</u>	
M. <u>2nd sd</u>		<u>5431</u>	<u>3607</u>	Pool
M. <u>Upper</u>	<u>5570</u>	<u>5570</u>	<u>3688</u>	<u>Harper Ranch</u>
K.				
Mz.				
Mq.				
V.				
S.				
S.				
A.				
R.				
PE.				
G.				
T.D.	<u>5535</u>			

Date Comm. 3-20-55 AUG 3 1955

16" @ 80/150 10 3/4" @ 573/350

DST 5408-54 open 45 min. Rec.

750' sgcm 1618/15" DST 5452-5535

open 1 hr. Rec. 180' mud 1105' muddy

sw 1960/15" 5 1/2" @ 5527 CO to 5509

96/ 5429-53 frac sq perf. CO to 5484

10/ 5448-53 10/ 5435-40 500 A

frac S/ 72 bo 120 bsw S/ 70 bw 20 hr.

OVER

AUG 10 1956

Scout Cards	
Land Small Map	
Land Wall Map	
Tracings	
Fr. ice Map	
Plan of Map	
MISC.	

1/5435 1/5440 1/5450 1/5456
200 A trac F/5 bo 1 hr.
S/94 bo - 194 bw 24 hr.
D & A