


Meade

KANSAS

SECTION 14 TOWNSHIP 34 RANGE 26W

WELL NO. #1 Easterday

COMPANY Michaelis Drlg.

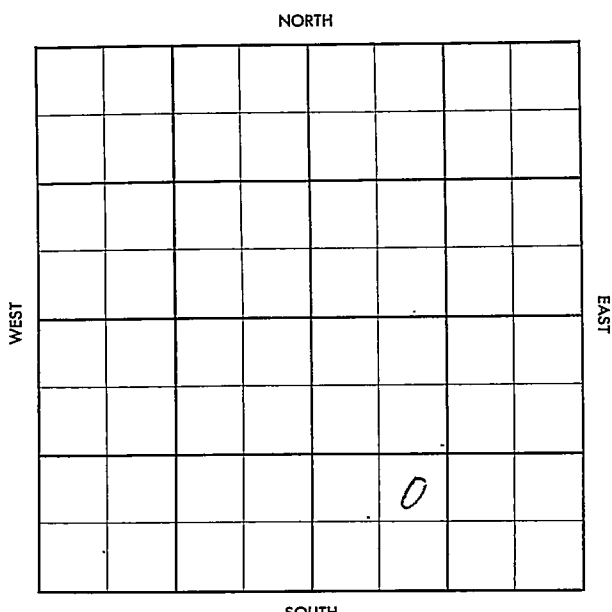

Meade

KANSAS

|      |      |     |
|------|------|-----|
| SEC. | TWP. | R.  |
| 14   | 34   | 26W |

WELL NO.

#1 Easterday

FARM

COMPANY

Michaelis Drlg.

CONTRACTOR

Co. Tools

Ft. from N. Line

1260


Ft. from S. Line

Ft. from E. Line

1170

Ft. from W. Line

NE SW SE

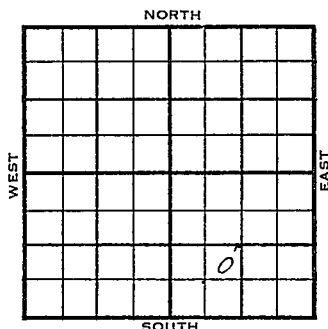

1956

ELEVATION

####

2185'

REPORT

5-2

Comm. 4-25-56

8" @ 1181 w/700

Drlg. 2710

7-11

5 1/2" @ 5857 w/300

Pf 48/5774-86, 16/ 5794-98, 12/5801-04

16/5807-11, 1000 A, G. 2,000 mcf.

G. 7000 MCF

7 mill. cfgpd

M. 5831' #

Log tops:

H. 4382'; L. 4575'; Marm 5253';

Mw. sh. 5729'; Mw. sd 5750-56';

TD 5860'

COMPLETED

County Meade Elev. \_\_\_\_\_  
 Sec. 14 Twp. 34 Rge. 26W  
 Company Michaelis Drlg.  
 Farm Name Easterday No. 1

| TOPS   | DEPTH | LOG | DATUM | Loc. in Sec. |
|--------|-------|-----|-------|--------------|
| Anb.   |       |     |       | NE SW SE     |
| Tr.    |       |     |       | 1260' SL     |
| H.     |       |     |       | 1170' WL     |
| Tr.    |       |     |       |              |
| Dg.    |       |     |       |              |
| BL.    |       |     |       |              |
| L.     |       |     |       | Geol.        |
| K.C.   |       |     |       | Contr.       |
| B.K.C. |       |     |       | Co. tools    |
| Ce.    |       |     |       |              |
| C.     |       |     |       | Pool         |
| M.     |       |     |       |              |
| M.     |       |     |       |              |
| K.     |       |     |       |              |
| Mz.    |       |     |       |              |
| Ma.    |       |     |       |              |
| V.     |       |     |       |              |
| S.     |       |     |       |              |
| S.     |       |     |       |              |
| A.     |       |     |       |              |
| R.     |       |     |       |              |
| Pe.    |       |     |       |              |
| G.     |       |     |       |              |
| T.D.   |       |     |       |              |

|              |  |
|--------------|--|
| FIRST REPORT |  |
| MAY 2 '56    |  |

Date Comm. 4-25-56

8" @ 1181/700 drlg. 2710

3301 7 VAM

County Meade Elev. 2195'  
 Sec. 14 Twp. 34 Rge. 26W  
 Company Michaelis Drlg.  
 Form Name Easterday No. 1

| TOPS                | DEPTH | LOG     | DATUM | Loc. in Sec.      |
|---------------------|-------|---------|-------|-------------------|
| Anh.                |       |         |       | NE SW SE          |
| Ip.                 |       |         |       |                   |
| H.                  |       | 4382    |       | 1260' SL          |
| Tr.                 |       |         |       | 1170' WL          |
| Dg.                 |       |         |       |                   |
| Bl.                 |       |         |       |                   |
| L.                  |       | 4575    |       | Geol.             |
| K.E. <u>Marm</u>    |       | 5253    |       | Contr.            |
| B.K.E. <u>Mw sh</u> |       | 5729    |       | Co. tools         |
| Ge. <u>" sd</u>     |       | 5750-50 |       | Pool <u>W. C.</u> |
| C.                  |       |         |       | <u>MISS. TST.</u> |
| M.                  |       |         |       |                   |
| M.                  | 5831  |         |       |                   |
| K.                  |       |         |       |                   |
| Mz.                 |       |         |       |                   |
| Mq.                 |       |         |       |                   |
| V.                  |       |         |       |                   |
| S.                  |       |         |       |                   |
| S.                  |       |         |       |                   |
| A.                  |       |         |       |                   |
| R.                  |       |         |       |                   |
| Pe.                 |       |         |       |                   |
| G.                  |       |         |       |                   |
| TD.                 | 5860  | 5815    |       |                   |

COMPLETE

Date Comm. 4-25-56 JUL 1 1 1956

8" @ 1181/700 drlg. 2710 MAY 9 '56

DP 4752 MAY 16 '56 DP 5551 MAY 23 '56

5 1/2 @ 5857/300 MAY 29 '56 W OCT JUN 6 '56

PF 48/5774-86 16/5794-98

12/5801-04 16/5807-11

1000 A G 2,000 MCF Free 6/6

G 7000 MCF TST JUN 13 '56 JUN 20 '56

JUN 27 '56 S.I. JUL 3 '56 JUL 11 '56 72-20

7 Mill. CFGPD