

Seward

KANSAS

SECTION 14 TOWNSHIP 34S RANGE 33W

WELL NO. #1-14 Salley


COMPANY P. E. P. L.

NORTH

N/2 NE SW

WEST

EAST

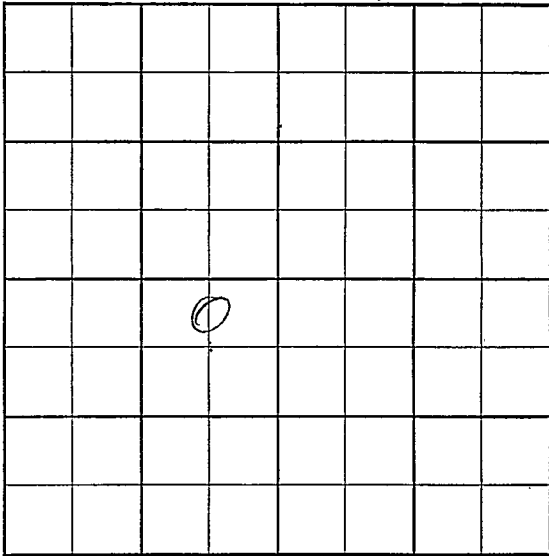

SOUTH

3

Lse

No



T.


Twp. N10 Pool N6

~~Section~~ Free

S-513-B

County Seward Elev 2831 OF 2834 RB
 Sec. 11 Twp. 3L Rge. 33W
 Company P. T. P. I.
 Farm Name Galley No. 1-11

TOPS	DEPTH	LOG	DATUM	Loc. in Sec.
Anh. <u>Hol</u>		<u>2562</u>		<u>1000' fwl x</u>
Tr. <u>Herr</u>		<u>2609</u>		
H. <u>Krid</u>		<u>2637</u>		<u>292.1 fwl</u>
Tr.				<u>N1 NE SW</u>
Dg.				
B.L.				
L.				
K.C.				Geol.
B.K.C.				Contr.
Ce. <u>2</u>				
C.				
M.				
M.				Pool
K.				<u>Hugoton</u>
Mz.				
Mq.				
V.				
S.				
S.				
A.				
R.				
Pf.				
G.				
T.D.	<u>2725</u>			

COMPLETE

SEP 3 '58

Date Comm. 5-26-58
 Location JUN 3 '58 7" 705/150 4" 2711/125
W OCT JUN 11 '58 CO 2674 20/2667-72
ga 150-muf + Ld + 6/2664-67
36/2644-62 14/2619-26 12/2610-16
2500A ga 1.275 muf + 10 graph
ga 2.099 muf + Ld ran + 6g JUN 18 '58
JUN 25 '58 JUL 2 '58 JUL 9 '58 JUL 16 '58 JUL 23 '58
JUL 30 '58 AUG 6 '58 AUG 13 '58 AUG 20 '58 AUG 27 '58
SEP 3 '58
up P10 2.099 MCF