


Section 14 Township 34 Range 34-W

Well No. #2 Keating - Stephens

Company Cabot Carbon

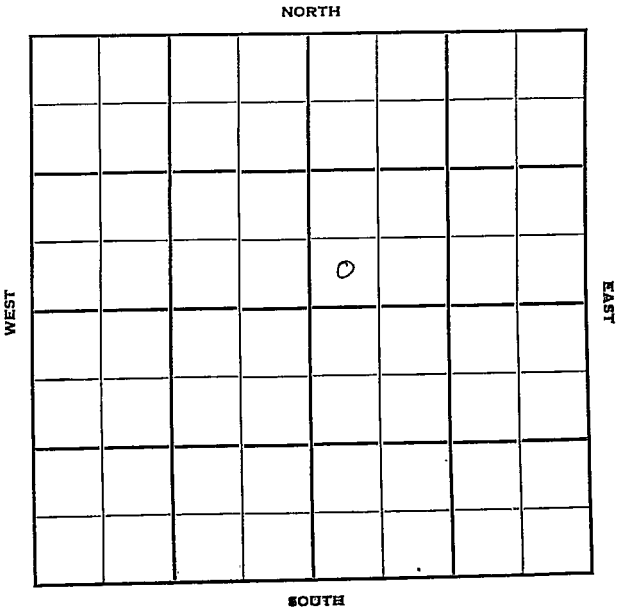

Seward

KANSAS

Sec. 14 Twp. 34 R. 34W

Well No. #2 Keating-Stephens Farm

Cabot Carbon Company

Hugoton Pool Contractor


 Ft. from N. Line

330' Ft. from S. Line

 Ft. from E. Line

330' Ft. from W. Line

SW SW NE

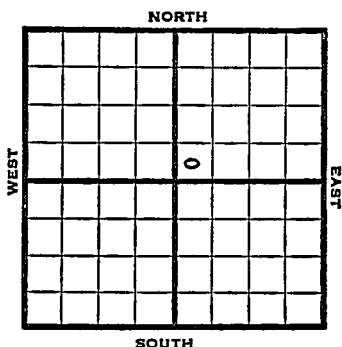

1950	Elev 2912' REPORT
10/25	Spud 10-16-50 10" @ 679' 7" @ 2627' TD 2637' WOC
12/6	10" @ 679 7" @ 2627 TD 2637 Her 2625 19000 A Comp 10,528,000 gas Completed COMPLETED

County Seward State KansasSec. 14 (Blk.
Twp.) 34 (Sur.
Rge.) 34W Map No.Operator Cabot CarbonWell No. 2 Farm Keating - StephensElev. Location SW SW NE

			0				

Blank Report


330 Ft. From S Line NE330 Ft. From W Line QuarterIst. Report OCT 25 1950

Completion

Remarks

Spudding Date 10-16-50Drlg. Data Hugoton Pool10" @ 679 7" @ 2627 TD 2637 WOC

J. E. TYRA

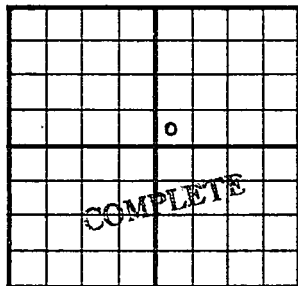County Seward State KansasSec. 14 (Blk.
Twp.) 34 (Sur.
Rge.) 3 4W Map No.Operator Cabot CarbonWell No. 2 Farm Keating - StephensElev. 2912 Location SW SW NE330Ft. From S Line NE330Ft. From W Line Quarter1st. ReportCompletion DEC 6 1950Remarks Hugoton PoolSpudding Date 10-16-50Drlg. Data Gas well TD 263710" C 679 7" C 2627 TD 2637 Her. 262519000 A Comp. 10,528,000 gas

J. E. TYRA