

Stevens County

Hugoton Pool


FORM 51 IOM 12-46 PETROL

KANSAS

Section 14 Township 34 Range 37W

Well No. 1 McGray

Company Republic Natural Gas

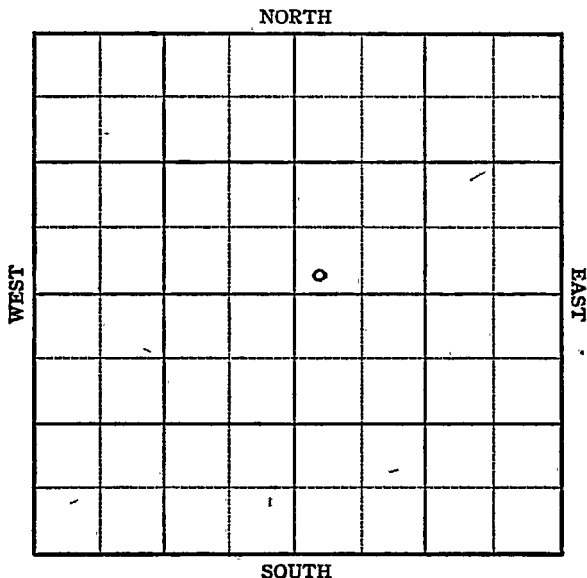

KANSAS

Stevens

Sec. 14 Twp. 34 R. 37-W

Well No. #1 McCray Farm

Republic Natural Gas Company

Hugoton Pool


 Ft. from N. Line

100 Ft. from S. Line

 Ft. from E. Line

100 Ft. from W. Line

SW NE

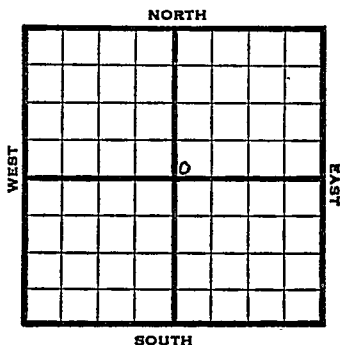

1947

3136

REPORT

2/26 Location

3/4 10" @ 671'
Drlg 800'

3/11 TD 2678'
7" @ 2670'
RUST

3/18 Drlg 2775'

3/25 TD 2900'
241' of 5" Perf liner @ 2900'

4/2 " " "

4/9 26500 acid

4/16 7" @ 2670'
241' of 5" Perf Liner @ 2900
26,500 Acid
26,363,000 Gas
397# R Pr
TD 29008

COMPLETED

Kansas KANSAS

Map No. _____ Sec. 14 Twp. 34 R. 37WWell No. 1 McCray

Republic Natural Gas Company

FIRST REPORT

Contractor _____

SW NE

SECTION PLAT

		o	

_____ Ft. from N. Line

100 Ft. from S. Line

_____ Ft. from E. Line

100 Ft. from W. Line

Stevens County

Location X

Rig up _____

Drilling and Remarks:

RECORD

Cased _____ in., _____ ft.

Sand _____

Gas _____

Oil _____

Total Depth _____

PRODUCTION

1st 24 hrs. Nat. _____

1st 24 hrs. after shot _____

Gas _____ Cu. Ft.

Dry Hole _____

Abandoned _____

Date

FEB 26 1947

19

S. J. LEWIS

Scout

Misc. Small Maps

Cards *WJH*

Tracing

France Map

Scarborough Map

Pierce Map

Geological Dept.

Pierce Post Book

Map No. _____ Sec. 14 Twp. 34 R. 37W

Well No. 1 McCray

Republic Natural Gas Company

COMPLETE

Contractor

SW NE

E18126


SECTION PLAT

_____ Ft. from N. Line

100 Ft. from S. Line

_____ Ft. from E. Line

100 Ft. from W. Line

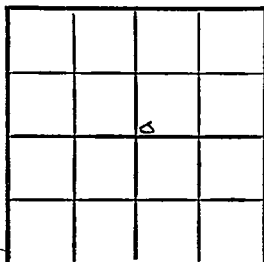

Stevens County

Location _____

Rig up _____

Drilling and Remarks:

7" @ 2670

241' 5" 5" Pex liner

@ 2900

26500 acid

26,363,000 Gas

299# R/A

RECORD

Cased _____ in, _____ ft.

Sand _____

Gas _____

Oil _____

Total Depth 2900

PRODUCTION

1st 24 hrs. Nat. _____

1st 24 hrs. after shot _____

Gas _____ Cu. Ft.

Dry Hole _____

Abandoned _____

Date

APR 16 1947 19

S. J. LEWIS Scout

Misc. Small Maps _____
Cards Done _____
Tracing _____
France Map _____
Scarborough Map _____
Pierce Map _____
Geological Dept. _____
Pierce Plat Book _____