


9-34-15W

STATE OF KANSAS
STATE CORPORATION COMMISSION

Form CP-4

Give All Information Completely
Make Required Affidavit
Mail or Deliver Report to:
Conservation Division
State Corporation Commission
P. O. Box 17027

Wichita, Kansas 67217
NORTH

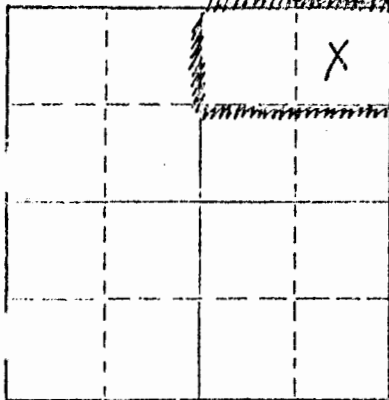

Locate well correctly on above
Section Plot

WELL PLUGGING RECORD

Barber County, Sec. 9 Twp. 34S Rge. (E) 15 (W)
Location as "NE/CNWSW" or footage from lines NE NE
Lease Owner Champlin Petroleum Company
Lease Name Davis Ranch "W" Well No. 1
Office Address 2601 NW Expressway, Suite 800E OKC OK 73112
Character of Well (completed as Oil, Gas or Dry Hole) Dry Hole
Date well completed 4-18 19 80
Application for plugging filed 6-9- 19 80
Application for plugging approved 19
Plugging commenced 4-19 19 80
Plugging completed 4-19 19 80
Reason for abandonment of well or producing formation Dry Hole
If a producing well is abandoned, date of last production 19
Was permission obtained from the Conservation Division or its agents before plugging was commenced? yes

Name of Conservation Agent who supervised plugging of this well William T. Owens
Producing formation Depth to top Bottom Total Depth of Well 4904 Feet
Show depth and thickness of all water, oil and gas formations.

OIL, GAS OR WATER RECORDS

CASING RECORD

FORMATION	CONTENT	FROM	TO	SIZE	PUT IN	PULLED OUT
				10 3/4	278	none

Describe in detail the manner in which the well was plugged, indicating where the mud fluid was placed and the method or methods used in introducing it into the hole. If cement or other plugs were used, state the character of same and depth placed, from feet to feet for each plug set.

Filled hole with heavy rotary mud from 4904' to 270'. Spot 50 sack cement plug at 270' half below and half inside surface casing. Finished filling hole with heavy mud to 40. Set solid 20 sack cement plug from 40' to 3'. Put 5 sacks cement in rat hole and 3 sacks cement in mouse hole.

Plugging operations accomplished utilizing Halliburton oil well cementing pumps truck through 4 1/2" drill pipe.