

SECTION 15 TOWNSHIP 34 RANGE 5 WWELL NO. #1 HranickaCOMPANY Falcon-Seaboard Drlg.

NORTH

①							

WEST

EAST

SOUTH

Harper

KANSAS

SEC. 15	TWP. # 34	R. 5W
------------	--------------	----------

WELL NO.

#1 Hranicka

FARM

COMPANY

Falcon-Seaboard Drlg.

CONTRACTOR

Co. Tools


WILDCAT

Ft. from N. Line

Ft. from S. Line

Ft. from E. Line

Ft. from W. Line

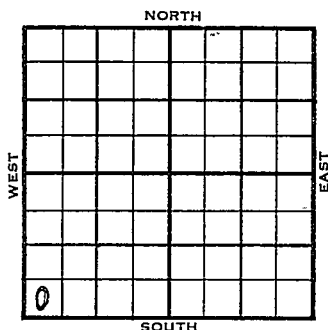

SW SW SW

Amerada - DHM

1956	ELEVATION 1218	REPORT
------	-------------------	--------

(Simp. Sd. test)

3-7 Comm. 3-6-56
10" @ 607
WOC

4-4 DST 5052-59 op 1 hr. rec. 75' mud, ###
1850/15"
DST 5057-74 op 1 hr. rec. 2760' sw, 0#
D & A
Stall 3515
BL. 3832
L. 3848
M. Li. 4533
K. 4957
V. 5023
S. Dolo 5033
S. Sd. 5055
TD 5074

ABANDONED

County Harter Elev. _____
 Sec. 15 Twp. 34 Rge. 5W
 Company Falcon-Seaboard Drlg.
 Farm Name Hranicka No. 1

TOPS	DEPTH	LOG	DATUM	Loc. in Sec.
Anh.				SW SW SW
Tr.				Simp. sd. test
H.				
Tr.				
Dg.				
BL.				
L.				Geol.
K.C.				Contr.
B.K.C.				Co. tools
Ce.				Pool
C.				Wildcat
M.				
M.				
K.				
Mz.				
Me.				
V.				
S.				
S.				
A.				
R.				
Pe.				
G.				
T.D.				

Date Comm. 3-6-56 Amerada - DHM
10" @ 607 WDC

FIRST REPORT
 MAR 7 1956

[Handwritten signature]

County Harper Elev. 1218
 Sec. 15 Twp. 34 Rge. 5W
 Company Falcon-Seaboard Drlg.
 Farm Name Kranicka No. 1

TOPS	DEPTH	LOG	DATUM	Loc. in Sec.
Anh.				
Tp <u>57911</u>	<u>3515</u>		<u>2297</u>	SW SW SW
H.				
Tr.				
Dg.				
BL.	<u>3832</u>		<u>2614</u>	
L.	<u>3848</u>		<u>2630</u>	
K.C.				Geol.
B.K.C.				Contr.
Ce.				
C.				Co. tools
M. <u>Li</u>	<u>4533</u>		<u>3315</u>	
M.				Pool
K.	<u>4957</u>		<u>3239</u>	Wildcat
Mz.				
Mq.				
V.	<u>5023</u>		<u>3805</u>	
S. <u>D210</u>	<u>5033</u>		<u>3815</u>	
S. <u>50</u>	<u>5055</u>		<u>3837</u>	
A.				
R.				
Pe.				
G.				
T.D.	<u>5074</u>			

Date Comm. 3-6-56
 10" @ 607 DST 5052-59 open 1 hr.
 rec. 75' mud 1850/15" DST 5057-74
 open 1 hr. rec. 2760' sw Off

D & A