

# KANSAS

Barber

Section 15 Township 34 Range 14W

Well No. 1 Kinkaid

Company Aladdin & CRA et al

Wildcat

NORTH

		0					

WEST

EAST

SOUTH

Sec. 15 Twp. 34 R. \_\_\_\_\_

Well No. #1 Kinkaid Farm \_\_\_\_\_  
Aladdin & CRA et al Company \_\_\_\_\_

Wildcat


1120' Ft. from N. Line

\_\_\_\_\_ Ft. from S. Line

990' Ft. from E. Line

\_\_\_\_\_ Ft. from W. Line

SW NE NW

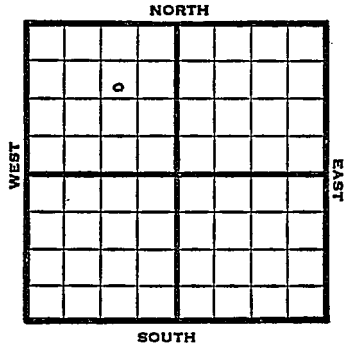

1949	Elev 1694'	REPORT
7/6	Surface Hole	
7/12	8" @ 337'	
7/20	Drlg 3220'	
7/27	Elgin 3887'	
	Douglas 4060'	
	Lansing 4188'	
	Drlg 4352'	
8/3	Miss 4815'	
	Drlg. 4818'	
8/10	5035 fsg.	
8/17	Misener 5180'	Viola 5184
	Simpson 5313'	
	Drlg. 5348'	
8/24	TD 5478' -	
	Arb. 5426'	
	Aband.	
	<b>ABANDONED</b>	

Map No. \_\_\_\_\_ Sec. 15 Twp. 34 R. 14W

Well No. 1 Kinkaid

Aladdin & CRA etal. Company

Patton Contractor

SW NE NW

FIRST REPORT  
SECTION FLAT

1120 Ft. from N. Line

\_\_\_\_\_ Ft. from S. Line

990 Ft. from E. Line

\_\_\_\_\_ Ft. from W. Line


Barber County

Location \_\_\_\_\_

Rig up \_\_\_\_\_

Drilling and Remarks:

surface hole

RECORD

Cased \_\_\_\_\_ in., \_\_\_\_\_ ft.

Sand \_\_\_\_\_

Gas \_\_\_\_\_

Oil \_\_\_\_\_

Total Depth \_\_\_\_\_

PRODUCTION

1st 24 hrs. Nat. \_\_\_\_\_

1st 24 hrs. after shot \_\_\_\_\_

Gas \_\_\_\_\_ Cu. Ft.

Dry Hole \_\_\_\_\_

Abandoned \_\_\_\_\_

Date

JUL 6 1949 19

S. J. LEWIS Scout

Map No. 193 Sec. 15 Twp. 34 R. 14W

Well No. 1 Kinkaid

Aladdin & CRA etal. Company

**ABANDONED** Contractor

SW NE NW

211684  
SECTION PLAT

1120 Ft. from N. Line

\_\_\_\_\_ Ft. from S. Line

990 Ft. from E. Line

\_\_\_\_\_ Ft. from W. Line


Barber County

Location \_\_\_\_\_

Rig up \_\_\_\_\_

Drilling and Remarks:

*CR 5426*

RECORD

Cased \_\_\_\_\_ in., \_\_\_\_\_ ft.

Sand \_\_\_\_\_

Gas \_\_\_\_\_

Oil \_\_\_\_\_

Total Depth 5475

PRODUCTION

1st 24 hrs. Nat. \_\_\_\_\_

1st 24 hrs. after shot \_\_\_\_\_

Gas \_\_\_\_\_ Cu. Ft.

Dry Hole \_\_\_\_\_

Abandoned \_\_\_\_\_

Date

AUG 24 1949 19

S. J. LEWIS Scout