

Clark

KANSAS

SECTION 15 TOWNSHIP 34S RANGE 25W

WELL NO. #1 Frame G. U.


COMPANY Atlantic & Skelly (25%)

NORTH

C SW/4

WEST

EAST

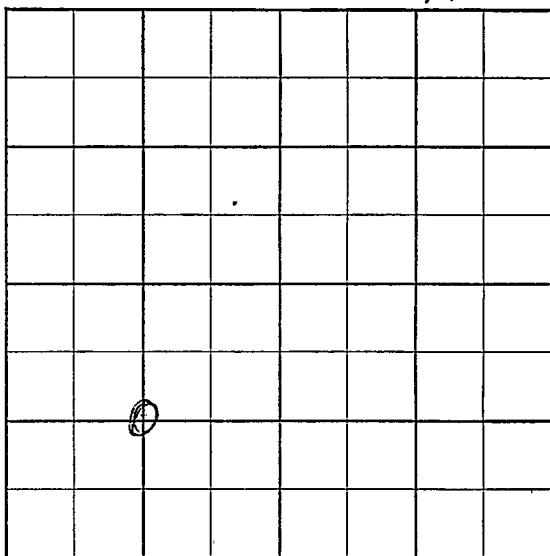

SOUTH

X X
 Pool
 X X
 Pool

S-513-B

County Clark Elev. _____
 Sec. 15 Twp. 34 Rge. 25W
 Company Atlantic & Skelly (25%)
 Farm Name Frame G. U. No. 1


TOPS	DEPTH	LOG	DATUM
Anh.			
Tp.			
H.			
Tr.			
Dg.			
B.L.			
L.			
K.C.			
B.K.C.			
Ce.			
C.			
M.			
M.			
K.			
Mz.			
Mq.			
V.			
S.			
S.			
A.			
R.			
Pf.			
G.			
T.D.			

Loc. in Sec. C SW/4

Geol. _____

Contr. Reaves Drlg.

Pool McKinney

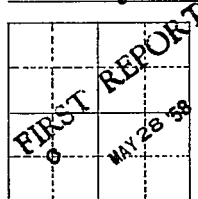

Date Comm. MIRT

Co.

Lse.

No.

Sec.

T.

R.

~~Twp~~ ~~Pool~~
~~Co~~ ~~Facet~~

5-13-B

County Clark Elev 226201 5265AB
 Sec. 15 Twp. 34 Rge. 25W
 Company Atlantic & Skelly (25%)
 Form Name Frame G. U. No. 1

TOPS	DEPTH	LOG	DATUM
Anh.			
Ip.			
H.	4281	4292	
Tr.			
Dg.			
B.L.			
L.	4471	4478	
K.C. <u>not</u>	5600	5594	
B.K.C. <u>Chest</u>	5609	5632	
Ce.			
C.			
M.			
M.			
K.			
Mz.			
Mq.			
V.			
S.			
S.			
A.			
R.			
Pf.			
G.			
T.D.	5860		

Loc. in Sec. SW/4

Geol.

Contr.

Reaves Drlg.

Pool

McKinney

COMPLETE

JUL 23 '58

Date Comm. 5-28-58

MRT JUN 3 '58 870 JUN 11 '58 8" 1202/650

4344 JUN 18 '58 5397 JUN 25 '58 DST

5611-70 1hr 30'm FP 15-35 BHP

515/30" DST 5663-5730 failed DST

5649-5800 1hr 8/17" ga 62 McF/10'

65' 59mm FP 30-40 BHP 1910/30" JUL 2 '58

5792/200 68/5666-83

48/5708-20 24/5750-56

JUL 9 '58 JUL 16 '58 8/5752-54

8/5712-14 8/5670-72 ext
 83-mef 4/5750-51 16/5708-12
 24/5714-20 ga 90-mef 16/
 5666-70 44/5672-83 ga 135
 mef raid frce ga 2.500-mef
 2 hrs 1.740-mef 13 hrs 2 ETP
 1225 FCP 1200 ~~200~~ JUL 23 58
 * 4 point ca op 5108.200
 MCF SICP 1738 SITP 1739
 miss 5666-5756
 TP 5800

15-34-25W

CSW/4