
Meade

KANSAS

SECTION 15 TOWNSHIP 34S RANGE 26W

WELL NO. #1 Harrington "B"

COMPANY Petroleum Inc.

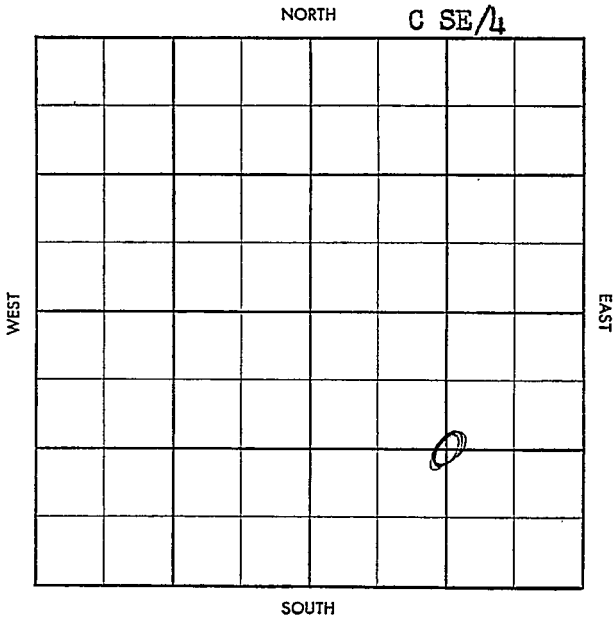

S-513-B

County Meade Elev.

Sec. 15 Twp. 34 Rge. 26W

Company Petroleum Inc.

Farm Name Harrington "B" No. 1

TOPS	DEPTH	LOG	DATUM
Anh.			
Tp.			
H.			
Tr.			
Dg.			
B.L.			
L.			
K.C.			
B.K.C.			
Ce.			
C.			
M.			
M.			
K.			
Mz.			
Mq.			
V.			
S.			
S.			
A.			
R.			
Pf.			
G.			
T.D.			

Loc. in Sec.
C SE/4
1350' NL
1250' WL

Geol.

Contr.
Garvey

Pool
McKinney



Date Comm. 4-11-58

8" @ 870/475 drlg. 1735

Co. Lse. No. Sec. T. R.

Twp. ____ Pool X

Co. X Feet ____

S-513-B

County Meade Elev. 2204D & 2207RB

Sec. 15 Twp. 34 Rge. 26W

Company Petroleum Inc.

Farm Name Harrington "B" No. 1

TOPS	DEPTH	LOG	DATUM
Anh.	1365		
Tp. Heve	2485		
H. U Kwid	2510		
Tr. L Kwid	2560		
Dg. Win	2608		
B. L. U Fr R. Ls	2659		
L. H	4442		
K.C. L	4617		
B.K.C.			
Ce.	5468	5466	
C. Ce Sd	5717		
M. Atoka	5732		
M. Mor Sh	5769	5771	
K. Mo. Li	5792		
Mz. Mor Sd	5807		
Mq. Chester	5839	5940	
V.			
S.			
S.			
A.			
R.			
Pf.			
G.			
T.D.	6040	6041	

Loc. in Sec. C SE/4

1350' NL

1250' WL

Geol.

Contr. Garvey

Lse.

Pool McKinney

ABANDONED

MAY 7 '58

0

No.

Date Comm. 4-11-58

Sec.

8" @ 870/475 drlg. 1735 APR 23 '58 Ø 4025

APR 30 '58 Ø 5535 MAY 7 '58 DST 5716-52

1hr 55' M NS all press 80/30"

DST 5767-5840 op 95" g/61" TSTM

195' Hgem FP 210 BHP 758/30 DST

5845-5925 op 75" 165' M FP 60

-190 BHP 1580/30" DST 5901-6005

1hr 40' M FP 60 BHP 1120/20 DST 5988

-6040 1hr 20' M all gas 0/30"

D & A

T.

R.