

KANSAS

FORM 51 25M 3-49 PETROL

Seward

Section 15 Township 34 Range 33-W

Well No. #1 Eubank "D"

Company Cities Service

NORTH

			0				

WEST

EAST

SOUTH

Sec. 15 Twp. 34 R.

Well No. #1 Eubank "D" Farm

Cities Service Company

Hugoton Pool Contractor


100' Ft. from N. Line

Ft. from S. Line

100' Ft. from E. Line

Ft. from W. Line

NE SW

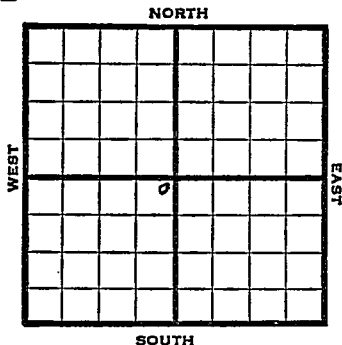

1950

Elev 2832' REPORT

9/20 Location

12/20 Spud 9-20-50

8" @ 640

TD 2850

5" @ 2749

Her 2588

Krider 2612

Win 2706

150/2650-80 80/2622-30 60/2596-2606

20/2678-80 PB 2674

100/2650-70 40/2622-30 50/2596-2606

12000 A

Comp 4,900,000 gas

Completed TD 2750'

COMPLETED

Scout Cards
Land Small Map
Land Wall Map
Tracings
France Map
Pierce Map
Misc.

SEP 22 1950

Scout Cards

Land Small Map

Land Wall Map

Tracings ..

Forest

Pierce Map

Misc.

F.W

5

DEC 7 1950

Orig. Data