


KANSAS

Stevens

Section 15 Township 34 Range 35W

Well No. 1 Skinner

Company Cites Service Gas
Hugoton

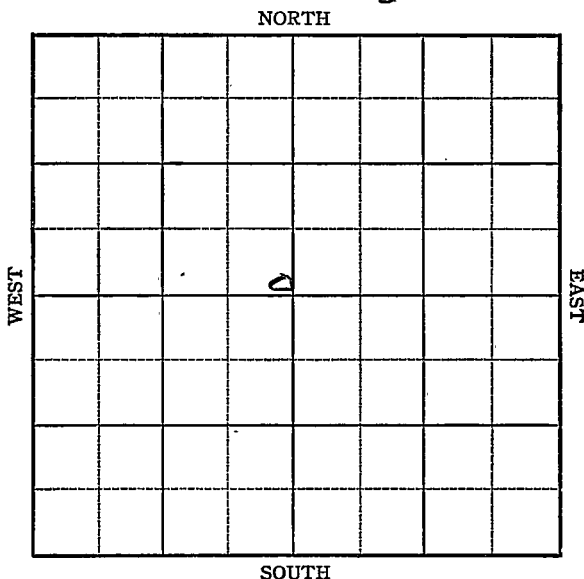

Stevens KANSAS

Sec. 15 Twp. 34 R. 35W ✓


Well No. #1 Skinner Farm

Cities Service Gas

Company

Hugoton Pool (McGill, Cont.)

NORTH

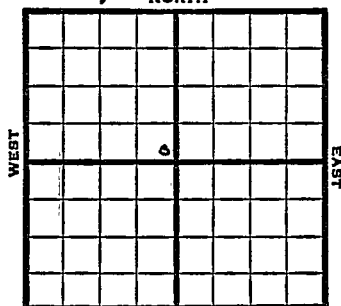

Ft. from N. Line

150'

Ft. from S. Line

150'

Ft. from E. Line

Ft. from W. Line

SE NW

SOUTH

1949

Elev 3015'

REPORT

6/15

RUR

6/21

"

6/28

10" @ 764'

TD 2700'

7" @ 2692'

7/6

TD 2834'

191' of 5" Perf Liner @ 2834

19000 acid

7/13

TD 2834'

7" @ 2692'

191' of 5" Perf Liner @ 2834

19000 acid

26,041,000 Gas

421# R Pr.

Comp

COMPLETED

Stevens County Kansas State

Map No. _____ Sec. 15 Twp. 34 R. 35W

Well No. 1 Skinner

Cities Service Gas Company

McGill Contractor

SE NW

FIRST REPORT SECTION PLAT

 Ft. from N. Line

150 Ft. from S. Line

150 Ft. from E. Line

 Ft. from W. Line

Hugoton Pool

Remarks:

R U R

Date
JUN 15 1949

Scout
S. J. LEWIS

Kansas

Map No. 2 Sec. 15 Twp. 34 R. 35WWell No. 1 Skinner

Cities Service Gas

Company

COMPLETE

Contractor

SE NW

E 1.3015
SECTION FLAT

Ft. from N. Line


150

Ft. from S. Line

150

Ft. from E. Line

Ft. from W. Line

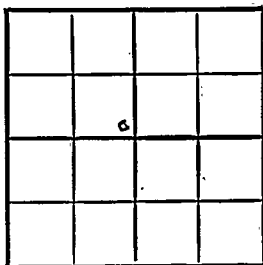

Stevens County

Location

Rig up

Drilling and Remarks:

7" C2692

1 91' of 5" Pay liner

C2834

19600 acid

26,041,000 gal

421* R/B

RECORD

Cased _____ in., _____ ft.

Sand _____

Gas _____

Oil _____

Total Depth 2834

PRODUCTION

1st 24 hrs. Nat. _____

1st 24 hrs. after shot _____

Gas _____ Cu. Ft.

Dry Hole _____

Abandoned _____

Date

JUL 13 1949

19

S. J. LEWIS Scout