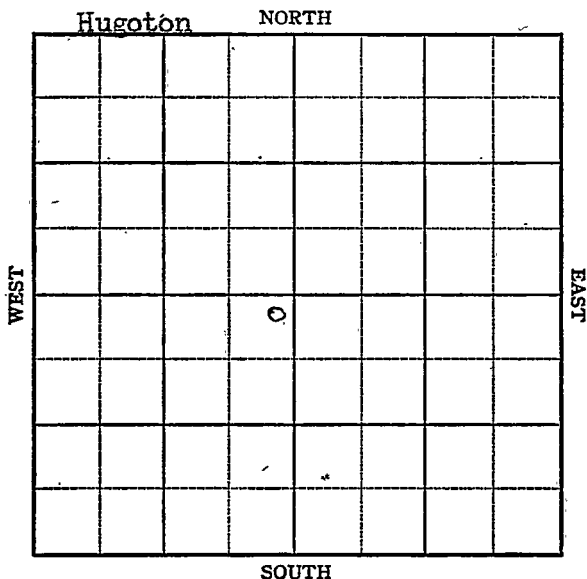



KANSAS

Stevens

Section 15 Township 34 Range 37WWell No. 1 CrawfordCompany Republic Natural Gas

KANSAS

Stevens

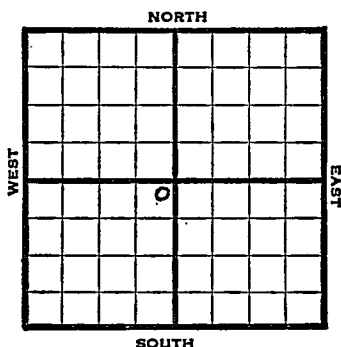Sec. 15 Twp. 34 R. 37-WWell No. #1 Crawford FarmRepublic Natural Gas Company100 Ft. from N. Line Ft. from S. Line100 Ft. from E. Line Ft. from W. Line

NE SW

1947

Elev. 3154' REPORT

4/9 10" set 709' WOC

4/15 TD 2687'
7" @ 2670'
RUST.

4/23 Drlg. 2850'

4/29 TD 2905'
240' of 5" Perf liner @ 2905'

5/7 21,000 Acid.

5/14 7" @ 2670'
240' of 5" Perf. liner
21000 Acid
29,468,000 Gas
378# R. Pr.
TD 2905'

COMPLETED

KANSAS
Kansas

Hugoton Pool

Map No. _____ Sec. 15 Twp. 34 R. 37W

Well No. 1 Crawford

Republic Natural Gas Company

-FIRST REPORT

Contractor

NE SW


SECTION PLAT

100 Ft. from N. Line

_____ Ft. from S. Line

100 Ft. from E. Line

_____ Ft. from W. Line

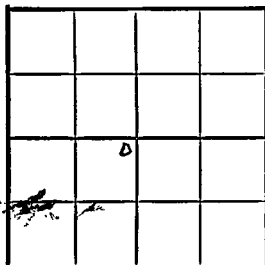

Stevens County

Location _____

Rig up _____

Drilling and Remarks:

10" @ 709 WOC

RECORD

Cased _____ in. _____ ft.

Sand _____

Gas _____

Oil _____

Total Depth _____

PRODUCTION

1st 24 hrs. Nat. _____

1st 24 hrs. after shot _____

Gas _____ Cu. Ft.

Dry Hole _____

Abandoned _____

Date

APR 9 1947

19

S. J. LEWIS

Scout

Map No. _____ Sec. 15 Twp. 34 R. 37W

Well No. 1 Crawford

Republic Natural Gas Company

COMPLETE

Contractor

NE SW

E 18154
SECTION PLAT

	d		

100 Ft. from N. Line

Ft. from S. Line

100 Ft. from E. Line

Ft. from W. Line

Stevens County

Location

Rig up

Drilling and Remarks:

7" @ 2670

240' of 5" Perf liner

21000 Acid

29,468,000 Cu

378 # R/P

RECORD

Cased _____ in., _____ ft.

Sand _____

Gas _____

Oil _____

Total Depth 2925

PRODUCTION

1st 24 hrs. Nat. _____

1st 24 hrs. after shot _____

Gas _____ Cu. Ft.

Dry Hole _____

Abandoned _____

Date

MAY 14 1947

19

S. J. LEWIS

Scout