


KANSAS

Morton

Section 15' Township 34 Range 41WWell No. 1 Morton "B"Company Cities Service

Hugoton

NORTH

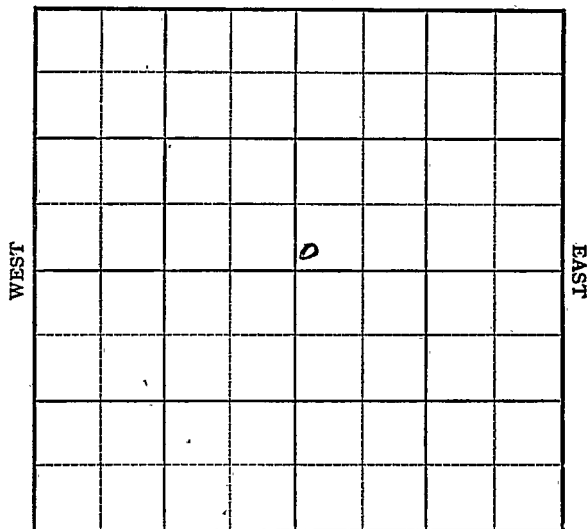

SOUTH

Morton

KANSAS

✓ 41W

Sec. 15 Twp. 34 R. 41W

Well No. #1 Morton "B" Farm

Cities Service

Company


Hugoton Pool (Holmes, Cont.) NORTH

Ft. from N. Line

100' Ft. from S. Line

Ft. from E. Line

100' Ft. from W. Line

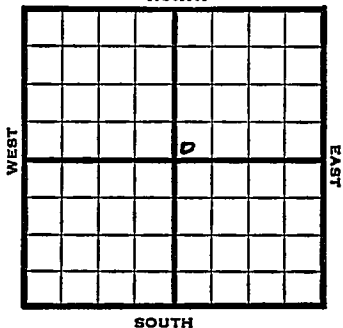

SW NE

SOUTH

1949

Elev. 3434' REPORT

7/20 8" @ 640'

7/27 5" @ 2380'

8/3 "

8/10 "

8/17 "

8/24 "

8/31 "

9/7 "

9/14 "

9/21 "

9/28 "

10/5 "

10/12 "

10/19 "

10/26 5" @ 2380'

Perf.

Acid 3000

Gas 9,970,000

R Pr. 391#

TD 2385'

COMPLETED

Kansas

Hugoton Pool

Map No. _____ Sec. 15 Twp. 34 R. 41W

Well No. 1 Morton "B"

Cities Service Company

Holmes Contractor

SW NE

FIRST REPORT
SECTION PLAT

_____ Ft. from N. Line

100 _____ Ft. from S. Line

_____ Ft. from E. Line

100 _____ Ft. from W. Line

Morton County

Location _____

Rig up _____

Drilling and Remarks: _____

8" @ 640

RECORD

Cased _____ in., _____ ft.

Sand _____

Gas _____

Oil _____

Total Depth _____

PRODUCTION

1st 24 hrs. Nat. _____

1st 24 hrs. after shot _____

Gas _____ Cu. Ft.

Dry Hole _____

Abandoned _____

Date

JUL 20 1949 19

S. J. LEWIS

Scout

Kansas

Hugoton Pool

Map No. _____ Sec. 15 Twp. 34 R. 41WWell No. 1 Morton "B"

Cities Service

Company

COMPLETE

Contractor


SW NE

E 1.3434.
SECTION PLAT

_____ Ft. from N. Line

100 Ft. from S. Line

_____ Ft. from E. Line

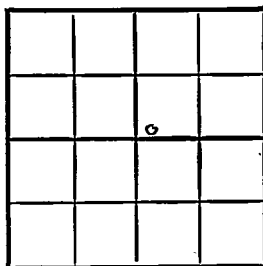100 Ft. from W. Line

Morton County

Location _____

Rig up _____

Drilling and Remarks:

*5' 1" 02380**Perf.*
*3000 acid**9,970,000 Gas**(29) # R/R*

RECORD

Cased _____ in., _____ ft.

Sand _____

Gas _____

Oil _____

Total Depth 2385

PRODUCTION

1st 24 hrs. Nat. _____

1st 24 hrs. after shot _____

Gas _____ Cu. Ft.

Dry Hole _____

Abandoned _____

Date

OCT 26 1949

19

S. J. LEWIS

Scout