Form 51—5M—3-35—Mid-West


Stevens

Map No. KANSAS Sec. 15 Twp. 34 R. 38 W

Well No. T. F. Kelley Farm

Stevens Co. Oil Co. Company

NORTH

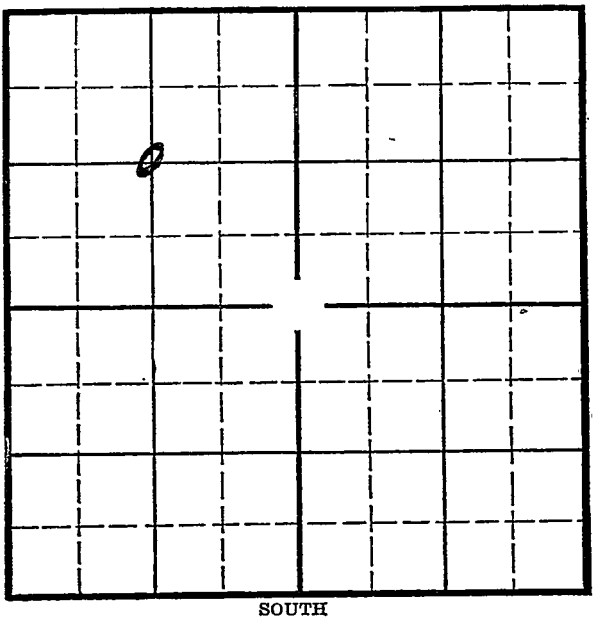

WEST

EAST

SOUTH

Location

Drilling Remarks

Rig Up

Drilling Remarks

RECORD

Cased ____ in. ____ ft.

Sand

Gas

Oil

Total Depth

PRODUCTION

1st 24 hrs. Nat.

1st 24 hrs. after shot

Gas ____ cu. ft.

Dry Hole

Abandoned

Form 252-A
5M 7-34 MPC

KANSAS

Stevens

Map No. _____ Sec. 15 Twp. 34 R. 38W

Well No. 1 - Kelley Farm


Stevens Co. Gas Co. Company

1320 Ft. from N. Line

_____ Ft. from S. Line

_____ Ft. from E. Line

1320 Ft. from W. Line

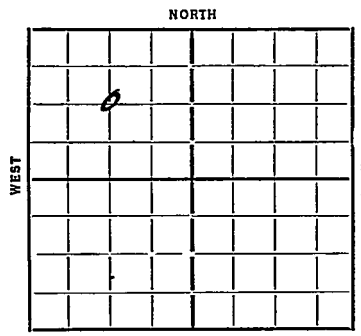

Elev. 3233

Date	REPORT
1935	
10/9	Dlg 2180 12" 615
11/1	7" 2560 SLM TD 2569 Rush
11/7	TD 2702 fsg Bailer
11/14	Dlg 2706
11/21	7" 2660 2710 ft Gas.
11/29	1 MM Gas
12/6	fsg
12/13	SD for 5" pipe to fish
12/19	— 12/26 — 12/30 — 1/6
1/17	fsg
1/24	—
1/31	Dlg By tools
2/7	fsg
2/14	—
2/21	SD
2/28	—
3/13	--
3/20	Fishing.
3/27	--4/2--4/10--
4/15	TD 2706
	D & A.
	ABANDONED.

Form 26 [illegible] 9-18-5

KANSAS

Map No. NM Sec. 15 Twp. 34 R. 36W


Well No. 1 - Kelley

Stevens Co. Oil & Gas Co. Company

Contractor

FIRST REPORTS

SECTION PLAT

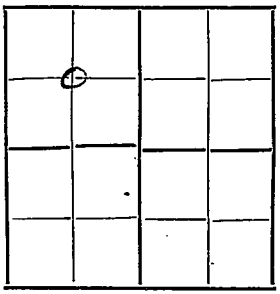

1320 Ft. from N. Line

Ft. from S. Line

Ft. from E. Line

1320 Ft. from W. Line

Location

Rig up

Drilling and Remarks:

12" 615

Dry 2180

RECORD

Cased in., ft.

Sand

Gas

Oil

Total Depth

PRODUCTION

1st 24 hrs. Nat.

1st 24 hrs. after shot

Gas Cu. Ft.

Dry Hole

Abandoned

Date

10-4-35 192

[illegible] Scout

Form 26 ~~PM Rks~~ 9-28

KANSAS

Stevens


Map No. No Map Sec. 15 Twp. 34 R. 38 W

Well No. 1 Kelly

Stevens Co. O & G. Company

Contractor

SECTION PLAT

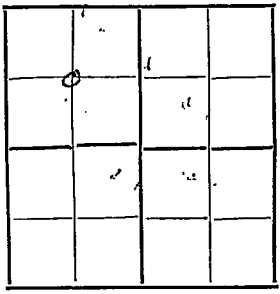

1320 Ft. from N. Line

Ft. from S. Line

Ft. from E. Line

1320 Ft. from W. Line

ABANDONED

Location

Rig up

Drilling and Remarks:

D&A

RECORD

Cased in., ft.

Sand

Gas

Oil

Total Depth 2706

PRODUCTION

1st 24 hrs. Nat.

1st 24 hrs. after shot

Gas Cu. Ft.

Dry Hole

Abandoned

Date

[illegible] 1936

192

Scout