


Form 51-5M-2-29-34703

Map No. 15 Sec. 34 Twp. 38 R. W

Well No. 2- Kelly Farm
Sidwell et al Company

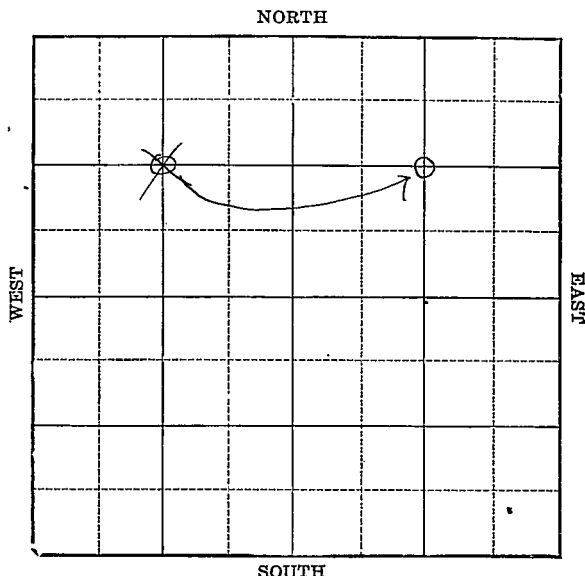

Location _____

Drilling Remarks _____

Rig Up _____

Drilling Remarks _____

RECORD

Cased _____ in. _____ ft.

Sand _____

Gas _____

Oil _____

Total Depth _____

PRODUCTION

1st 24 hrs. Nat. _____

1st 24 hrs. after shot _____

Gas _____ cu. ft. _____

Dry Hole _____

Abandoned _____

Map No. KANSAS Sec. 15 Twp. 34 R. 38

Well No. 2-Kelly Farm

Edwell et al Company


1320 Ft. from N. Line

_____ Ft. from S. Line

_____ Ft. from E. Line

1320 Ft. from W. Line

1930

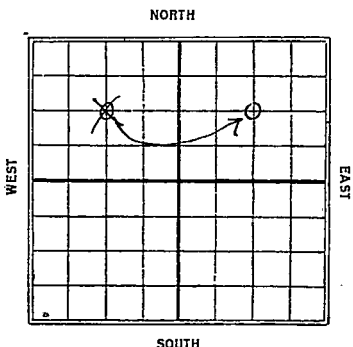

Date

REPORT

6/11	Loc
6/18	—
6/25	—
7/2	hrlg water well
7/9	—
7/16	Reg
7/23	—
7/30	—
8/6	—
8/13	—
8/20	—
8/27	12" - 625'
9/3	hrlg. 1870'
9/10	Std drlg pipe 2020
9/17	—
9/24	SD 2020'
10/1	No report
10/8	—
10/22	T.D. 2565 Rust
10/29	—
11/5	hrlg. 2820 Est. 9 PM gas

Map No. KANSAS Sec. 15 Twp. 34 R. 35W

Well No. 2 Kelly

Seiler W. & Co. Company

Contractor


SECTION PLAT

1820 Ft. from N. Line

..... Ft. from S. Line

..... Ft. from E. Line

1820 Ft. from W. Line

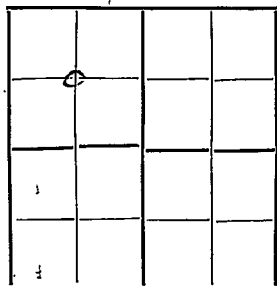

FIRST REPORTS

Location ✓

Rig up

Drilling and Remarks:

RECORD

Cased..... in., ft.

Sand.....

Gas.....

Oil.....

Total Depth.....

PRODUCTION

1st 24 hrs. Nat.....

1st 24 hrs. after shot.....

Gas..... Cu. Ft.

Dry Hole.....

Abandoned.....

Date

JUN 11 1930

S. J. LEWIS Scout

Stevens
 Map No. **KANSAS** Sec. 15 Twp. 34 R. 38W

Well No. 2 TE 112

Richard E. D. & Co. Company

Contractor


SECTION PLAT

1320 Ft. from N. Line

..... Ft. from S. Line

1820 Ft. from E. Line

..... Ft. from W. Line

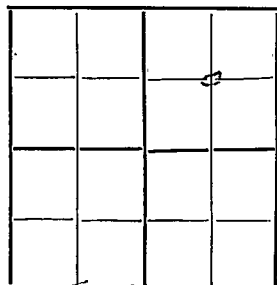

CORRECTION

Location ✓

Rig up

Drilling and Remarks:

Repealed
C. W. H.

RECORD

Cased in., ft.

Sand

Gas

Oil

Total Depth

PRODUCTION

1st 24 hrs. Nat.

1st 24 hrs. after shot

Gas Cu. Ft.

Dry Hole

Abandoned

Date

JUN 25 1930

S. J. LEWIS Scout

Map No. KANSAS Sec. 15 Twp. 34 R. 38WWell No. 2 KellyBidwell & Co. Company

Contractor

SECTION PLAT


1320 Ft. from N. Line

Ft. from S. Line

1320 Ft. from E. Line

Ft. from W. Line

COMPLETED

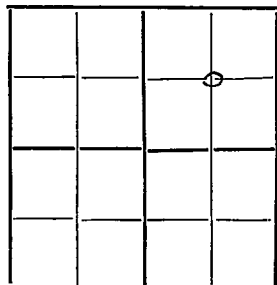

Location

Rig up

Drilling and Remarks: 11

RECORD

Cased _____ in., _____ ft.

Sand 2565 - 2832Gas 9.11

Oil _____

Total Depth 2832

PRODUCTION

1st 24 hrs. Nat. _____

1st 24 hrs. after shot _____

Gas _____ Cu. Ft.

Dry Hole _____

Abandoned _____

Date

NOV 12 1930

S. J. LEWIS

Scout