


Section 15 Township 34 Range 42WWell No. 1 Riley "B"Company Panhandle Eastern

NORTH

WEST

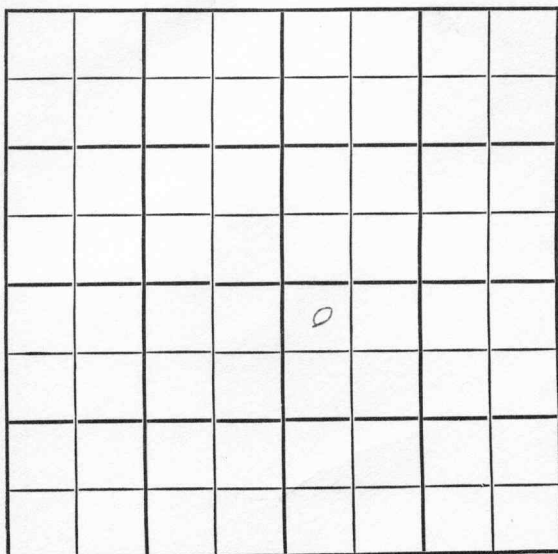

EAST

SOUTH

Morton KANSAS

SEC.	TWP.	R.
15	34	42W

WELL NO.

1 Riley "B"

FARM

COMPANY

Panhandle Eastern

CONTRACTOR

Garvey

Greenwood Gas Pool

Ft. from N. Line


2440

Ft. from S. Line

2490

Ft. from E. Line

Ft. from W. Line

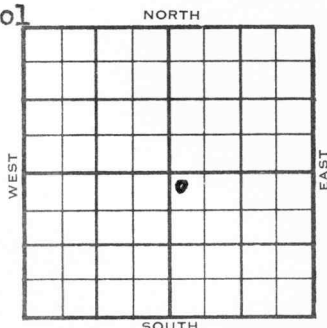

NW NW SE

ELEVATION

REPORT

1955

4/27

Spud 4-23-55
10" @ 593', WOC

6/8

Anh Waub 2644
TP 2864
L 3114
TD 3231
10" @ 593/325 7" @ 3200/300 CO
24/3134-40 40/3124-34 1000 A
50 gwph 12hr sq perf 2980-92
2996-3010 3028-34 3043-49
3056-71 464 mcfg 2000 A 54 mcfg SP
2965 perf 2946-52 2923-33 2907-13
2½ mcfg CO perf 2893-97 7,643 mcfg
1000 A 10,812 mcfg 4000 A 13,241
mcfg 6000 A Comp 38,448 mcfgpd 412#

COMPLETED

CountyMortonElev.

Sec.15Twp.34Rge.42W

CompanyPanhandle Eastern

FarmNameRiley "B"No.1

TOPS	DEPTH	LOG	DATUM	Loc. in Sec.
Anh. W a u b		2644		NW NW SE
T.p.		2867		
H.				2440' SL
Tr.				
Dg.				2490' EL
B.L.				
L.		3114		Geol.
K.C.				
B.K.C.				Contr.
Ce.				Garvey
C.				
M.				Pool
M.				
K.				Greenwood
Mz.				
Mq.				
V.				
S.				
S.				
A				
R.				
Pe.				
G.				
T.D.	32.31			

Date Comm.4-23-55JUN81955

10" @ 593/3257" @ 3200/300CO

24/ 3134-4040/ 3124-341000 A

50 gwph 12 hr. sq perf/ 2980-92

2996-30103028-343043-493056-71

464 mcfg 2000 A54 mcfg SP 2965

perf/ 2946-522923-332907-13

2½ mcfg CO perf/ 2893-977,643 mcfg

1000 A10,812 mcfg4000 A13,241 mcfg

6000 AComp. 38,448 mcfgpd412#