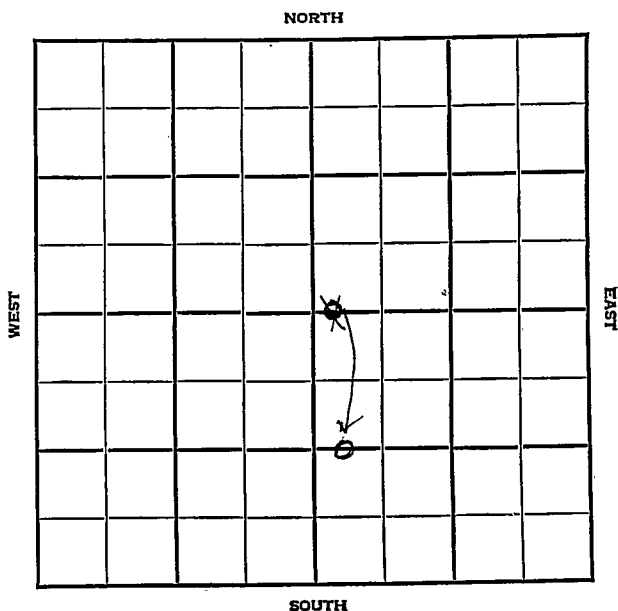
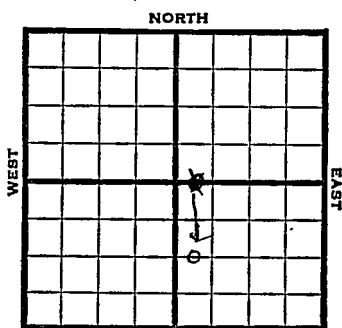


Section 15 Township 34 Range 39WWell No. #1 ReedCompany Panhandle Eastern

KANSAS Stevens

Sec. 15 Twp. 34 R. 39WWell No. #1 Reed FarmPanhandle Eastern Company

Hugoton

1320 Ft. from N. Line1324 Ft. from S. Line2339 Ft. from E. Line330 Ft. from W. LineC W L E₂ Sec. C W L W $\frac{1}{2}$ SE

1947	REPORT
10/1	Location
10/8	10" @ 589' Drlg. 1400'
10/15	TD 2582' 7" @ 2567' RUST
10/22	TD 2794 239' of 5" perf liner @ 2794'
10/29	"
11/5	"
11/12	"
11/19	"
11/25	"
12/3	"
12/10	15000 acid
12/17	7" @ 2567' 239' of 5" perf liner @ 2794' 15,500 acid 29,870,000 Gas 364# RPr TD 2794'
	COMPLETED

Map No. _____ Sec. 15 Twp. 34 R. 39W

Well No. 1 Reed

Panhandle Eastern Company

1ST REPORT

Contractor

C W L E $\frac{1}{2}$ Sec.


SECTION PLAT

_____ Ft. from N. Line

1324 Ft. from S. Line

2339 Ft. from E. Line

_____ Ft. from W. Line

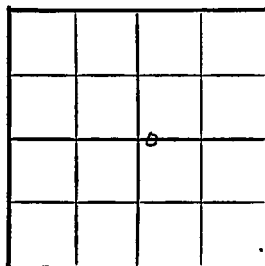

Stevens County

Location X

Rig up _____

Drilling and Remarks:

RECORD

Cased _____ in., _____ ft.

Sand _____

Gas _____

Oil _____

Total Depth _____

PRODUCTION

1st 24 hrs. Nat. _____

1st 24 hrs. after shot _____

Gas _____ Cu. Ft.

Dry Hole _____


Abandoned _____

Date

OCT 1 1947 19 S. J. LEWIS Scout

Map No. 0 Sec. 15 Twp. 34 R. 39WWell No. 1 ReedPanhandle Eastern CompanyCORRECTION Contractor^{wh}
C W L SE

SECTION PLAT.

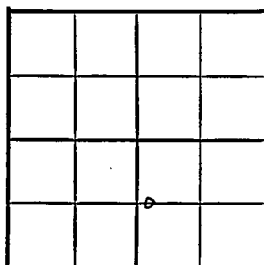 Ft. from N. Line1320 Ft. from S. Line Ft. from E. Line330 Ft. from W. LineStevens CountyLocation Rig up

Drilling and Remarks:

Reported

C W L E $\frac{1}{2}$ Sec.

RECORD

Cased in., ft.Sand Gas Oil Total Depth

PRODUCTION

1st 24 hrs. Nat. 1st 24 hrs. after shot Gas Cu. Ft.Dry Hole Abandoned

Date

OCT 22 1947 19S. J. LEWIS Scout

Map No. _____ Sec. 15 Twp. 34 R. 39W

Well No. 1 Reed

Panhandle Eastern Company

COMPLETE

Contractor

C W L SE

E 13288


SECTION PLAT

_____ Ft. from N. Line

1320 Ft. from S. Line

_____ Ft. from E. Line

330 Ft. from W. Line

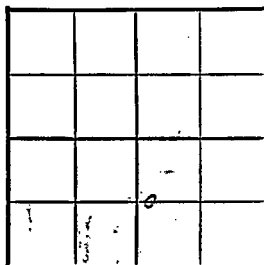

Stevens County

Location _____

Rig up _____

Drilling and Remarks:

7 "C 2567

289' by 5" Pay line

@ 2794

15,500 acid

29,870,000 gal

364 R Pe*

RECORD

Cased _____ in., _____ ft.

Sand _____

Gas _____

Oil _____

Total Depth 2784

PRODUCTION

1st 24 hrs. Nat. _____

1st 24 hrs. after shot _____

Gas _____ Cu. Ft.

Dry Hole _____

Abandoned _____

Date

DEC 1 7 1947 19

S. J. LEWIS Scout