


Section 15 Township 34 Range 11WWell No. 1 CircleCompany Coppinger & Brimm

Wildcat

NORTH

WEST

EAST

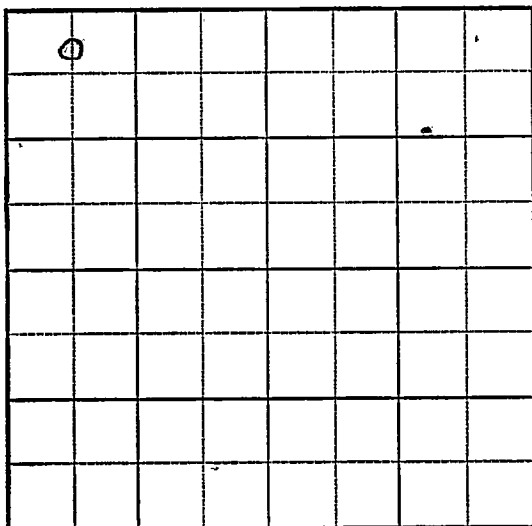

SOUTH

KANSAS

Barber

HOT FILE

Sec. 15 Twp. 34 R. 11W

Well No. #1 Circle Farm

Coppinger & Brimm Company

Wildcat


330' Ft. from N. Line

Ft. from S. Line

Ft. from E. Line

660' Ft. from W. Line

C N L NW NW

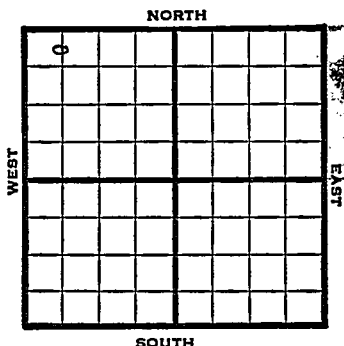

1949

REPORT

2/2 Location

2/9 Location

2/16 "

2/23 "

3/2 "

3/8 "

3/16 "

3/23 "

3/29 "

4/6 "

4/12 "

4/20 "

4/27 "

5/4 "

5/10 "

5/18 Location

Aband.

ABANDONED

Map No. _____ Sec. 15 Twp. 34 R. 11W

Well No. 1 Circle

Coppinger & Brimm Company

FIRST REPORT Contractor

C N L NW NW

SECTION PLAT

0			

330 Ft. from N. Line

_____ Ft. from S. Line

_____ Ft. from E. Line

660 Ft. from W. Line

Barber County

Location X

Rig up _____

Drilling and Remarks:

RECORD

Cased _____ in., _____ ft.

Sand _____

Gas _____

Oil _____

Total Depth _____

PRODUCTION

1st 24 hrs. Nat. _____

1st 24 hrs. after shot _____

Gas _____ Cu. Ft.

Dry Hole _____

Abandoned _____

Date

FEB 2 1949

S. J. LEWIS Scout

Map No. _____ Sec. 15 Twp. 34 R. 11W

Well No. 1 Circle

Coppinger & Brimm Company

ABANDONED

Contractor

C N L NW NW

SECTION PLAT

330 Ft. from N. Line

_____ Ft. from S. Line

_____ Ft. from E. Line

660 Ft. from W. Line

6			

Barber County

Location ✓

Rig up _____

Drilling and Remarks:

RECORD

Cased _____ in., _____ ft.

Sand _____

Gas _____

Oil _____

Total Depth _____

PRODUCTION

1st 24 hrs. Nat. _____

1st 24 hrs. after shot _____

Gas _____ Cu. Ft.

Dry Hole _____

Abandoned _____

Date

MAY 18 1949 19

S. J. LEWIS Scout