

Barber


KANSAS

SECTION 16 TOWNSHIP 34 RANGE 12 W

WELL NO. #1 Vestal

COMPANY Monsanto

NORTH

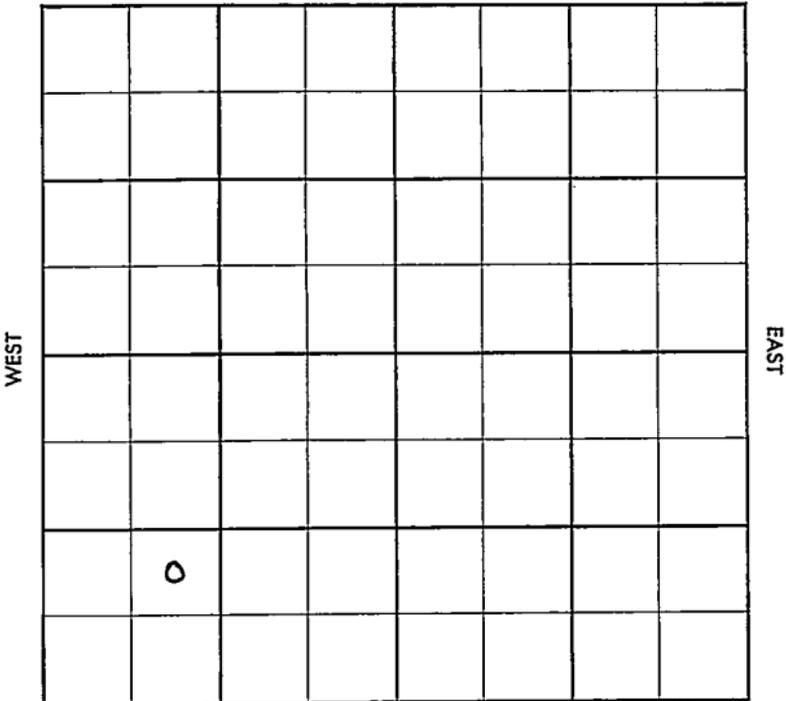

SOUTH

Barber

KANSAS


SEC.	TWP.	R.
16	34	12W

WELL NO. #1 Vestal FARM

COMPANY Monsanto

CONTRACTOR G-M-R Hardtner

_____ Ft. from N. Line
 _____ Ft. from S. Line
 _____ Ft. from E. Line
 _____ Ft. from W. Line
 NE SW SW

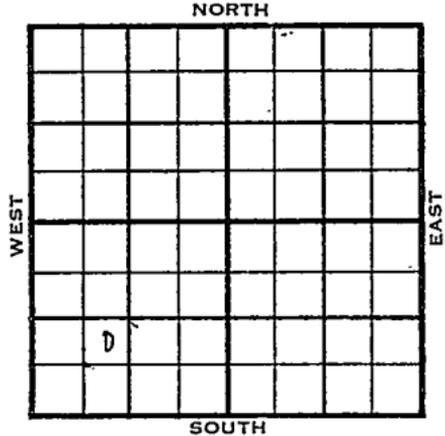

	ELEVATION	REPORT
1956		
1-25	MIR	

County Barber Elev. _____
 Sec. 16 Twp. 31 Rge. 12W
 Company Monsanto
 FarmName Vestal No. 1

TOPS	DEPTH	LOG	DATUM
Anh.			
Tp.			
H.			
Tr.			
Dg.			
Bl.			
L.			
K.C.			
B.K.C.			
Ce.			
C.			
M.			
M.			
K.			
Mz.			
Me.			
V.			
S.			
S.			
A.			
R.			
PE.			
G.			
T.D.			

Loc. in Sec. NE SW SW

Geol. _____
 Contr. G-M-R

Pool Hardtner

FIRST REPORT
 JAN 25 1956

Date Comm. MIR

[Handwritten signature]

Co.
Lse.
No.
Sec.
T.
R.



2

6

JAN 3 1 1956

R. G.

County Barber Elev. 1479 DF
 Sec. 16 Twp. 34 Rge. 12W
 Company Monsanto
 Farm Name Vestal No. 1

TOPS	DEPTH	LOG	DATUM	Loc. in Sec.
Ann				NE SW SW
Top	<u>5195d</u>		<u>2104</u>	
H.	<u>3803</u>		<u>2324</u>	
Tc.				
Dg	<u>3861</u>		<u>2382</u>	
Bl				
✓	<u>4001</u>		<u>2522</u>	Geol.
L.				
K.C.				Contr.
R.C.				
Cc.				<u>G-M-R</u>
C.				
✓	<u>4697</u>		<u>2318</u>	Pool
M.	<u>Chert</u>		<u>3225</u>	
N.				<u>Hardtner</u>
K.				
Mr.				
Mo				
V.				
S.				
S.				
A				
R.				
PE				
G.				
TD	✓	<u>4800</u>		

FEB 22 1956

Date Comm.

M I R FEB 1 '56 1-25-56 85/8

349/275 @ 3840 FEB 8 '56

DST 4683-4727 @ 1 1/2" to 5
10" TST M @ 40' GCM FEP 7

BHP 1470/20 DST 4728-60
@ 44" @ 15" Md BHP

15/20" 5 1/2 @ 4790 1/2/150

FEB 15 '56 @ 60/4719-29 1/2

@ 59 GWT + 2 @ 75T 1/2 BU

ABANDONED

MAR 1 1956

R. G.

AD 30

In Oil Pac. #2224 tsd. 82
of in 1hr (8.4/10 gal. used)