

Harper

KANSAS

SECTION 16 TOWNSHIP 34 RANGE 7

WELL NO. #1 Cather

COMPANY J. I. Huber

NORTH

							6

WEST

EAST

SOUTH

Harper

KANSAS

SEC.

TWP.

R.

16

34

7W

WELL NO.

#1 Cather

FARM

COMPANY

~~#####~~ J.M. Huber

CONTRACTOR

~~##~~ G-M-R

WILDCAT


_____ Ft. from N. Line

_____ Ft. from S. Line

_____ Ft. from E. Line

_____ Ft. from W. Line

NE SE NE

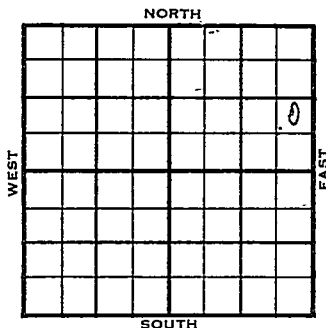

Continental FO

	ELEVATION	REPORT
1955	1402	
12-28	Comm. 12-27-55	
<u>1956</u>		
1-25	8 5/8" @ 317/250	
	DST 3845-53 op 45 min. rec. 1975' gcsw	
	1620/15"	
	D & A	
	Tp. 3045	
	LeComp. 3235	
	Heeb. 3365	
	Leavan 3375	
	Tor. 3515	
	Stal. 3843-3842	
	Stal Sd. 3877	
	KC 4082-4082	
	Marm 4400	
	Ft. Scott 4515	
	Ce lime 4531	
	Ce Sh. 4566	
	Miss ch. 4690-4697	
	Miss. lm. 4710	
	Kh sh. 5033	
	Chatta 5122- 5118	
	Viola 5150 - 5151	
	Simp. 5182-5175	
	A. 5393	
	TD 5451'	

ABANDONED

County Harper Elev. 1402
 Sec. 16 Twp. 34 Rgs. 7W
 Company J. M. Huber
 Farm Name Cather No. 1

Co.

TOPS	DEPTH	LOG	DATUM
Anh.			
TP	3045		1643
H. <u>L & Comp</u>	3235		1833
Tr. <u>Neel</u>	3365		1963
Dg. <u>Lavan</u>	3375		1973
Bl. <u>Nav.</u>	3515		2113
L. <u>Stal</u>	3843	3842	2440
K.C. " <u>sd</u>	3877		2475
B.K.C. <u>KC.</u>	4082	4082	2680
Ce. <u>Marm</u>	4400		2998
C. <u>77 Scott</u>	4515		3113
M. <u>Carlina</u>	4531		3129
M. " <u>sh</u>	4566		3164
K. <u>Miss ch</u>	4690	4697	3295
Mz. " <u>br</u>	4710		3328
Mo. <u>Kh sh</u>	5033		3631
V. <u>Chatta</u>	5122	5118	3716
S. <u>Viola</u>	5150	5151	3749
S. <u>Simp</u>	5182	5175	3773
A		5393	3991
R.			
PE.			
G.			
TD.	5451		

Loc. in Sec. NE SE NE

Geol.

Contr.

G-M-R

Pool

Wildcat

ABANDONED

Loc.

No.

Sec.

T.

R.

Date Comm. 12-27-55 JAN 25 1956

8 5/8" @ 317/250 DST 3845-53

open 45 min. rec. 1975' gcsw

1620/15"

D & A

Co.

Sec.

No.

Sec.

T.

R.

 Sec. 16 Twp. 34 Rge. 7W
 Company J. K. Huber
 Farm Name Cather No. 1

TOPS	DEPTH	LOG	DATUM
Anh.			
Tr.			
H.			
Tr.			
Dg.			
Bl.			
L.			
K.C.			
B.K.C.			
Ce.			
C.			
M.			
M.			
K.			
Mz.			
Me.			
V.			
S.			
S.			
A.			
R.			
PE.			
G.			
T.D.			

Loc. in Sec. NE SE NE

Geol. _____
 Contr. E-M-R

Pool Wildcat

DEC 28 '55	0
FIRST REPORT	

Date Comm. 12-27-55 Continental FO

[Handwritten signature and scribbles]