


Section 16 Township 34 Range 33W

Well No. #1 Salley "C"

Company Cities Service

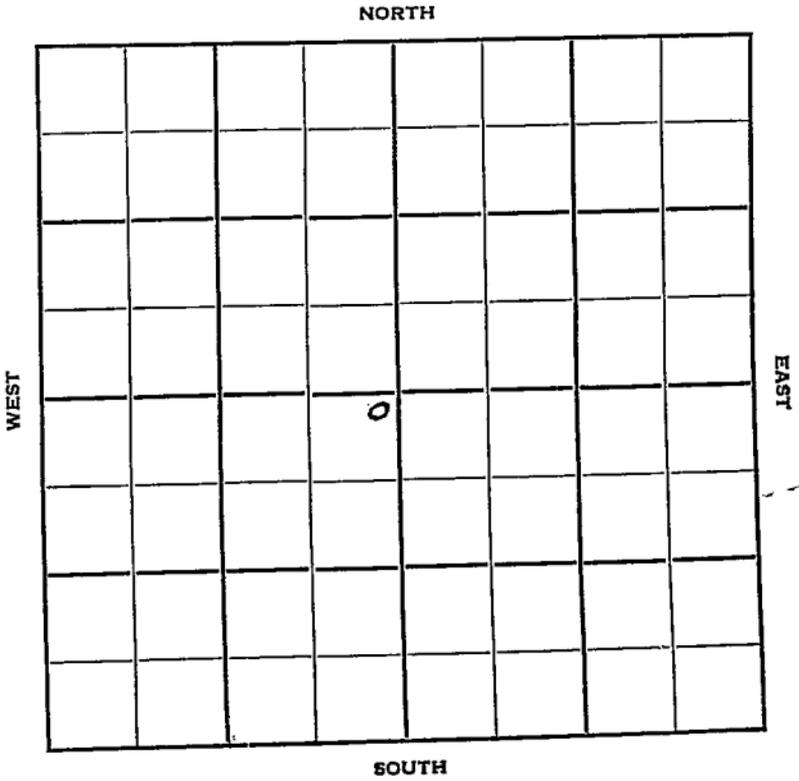

Sec. 16 Twp. 34 R. 33-W

Well No. #1 Salley "C" Farm

Cities Service Company

Contractor

Hugoton Pool


100 Ft. from N. Line

Ft. from S. Line

100 Ft. from E. Line

Ft. from W. Line

NE SW

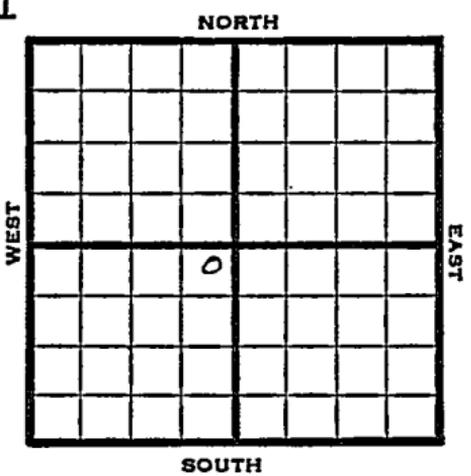

1950

Elev 2867' REPORT

2/1

Spud 1-30-50
8" @ 679'
WOC

3/29

TD 2805'
8" @ 679'
5" @ 2804'
Herr 2608'
U Kr 2633'
L Br 2663'
Winn 2720'
15,100,000
CFGPD
Comp

COMPLETED

Map No. _____ Sec. 16 Twp. 34 R. 33W

Well No. 1 Salley "C"

Cities Service Company

Contractor

NE SW

SECTION PLAT

100 Ft. from N. Line

_____ Ft. from S. Line

100 Ft. from E. Line

_____ Ft. from W. Line



Seward County

Location _____

Rig up _____

Drilling and Remarks:

Spud 1-30-50.

8" @ 679

WOC

RECORD

Cased _____ in., _____ ft.

Sand _____

Gas _____

Oil _____

Total Depth _____

PRODUCTION

1st 24 hrs. Nat. _____

1st 24 hrs. after shot _____

Gas _____ Cu. Ft.

Dry Hole _____

Abandoned _____

Date

FEB 1 1950 19

J. E. TYRA Scout

FEB

Scout Cards
Land Small Map
Land Wall Map 37
Tracings
France Map
Pierce Map
Misc.

South
71950

Kansas

Map No. _____ Sec. 16 Twp. 34 R. 33W

Well No. 1 Salley "C"

Cities Service Company

Contractor

NE SW

E. 2867
SECTION PLAT

100 Ft. from N. Line

_____ Ft. from S. Line

100 Ft. from E. Line

_____ Ft. from W. Line

COMPLETE			
	o		

Seward County

Location _____

Rig up _____

Drilling and Remarks:

8" @ 679

5" @ 2804

Kerr 2608

V Kr 2633

L Kr 2663

Win 2720

15,100,000

Date

CFGPD

RECORD

Cased _____ in., _____ ft.

Sand _____

Gas _____

Oil _____

Total Depth 2805

PRODUCTION

1st 24 hrs. Nat. _____

1st 24 hrs. after shot _____

Gas _____ Cu. Ft.

Dry Hole _____

Abandoned _____

MAR 29 1950

J. E. TYRA

Scout

CORRECTION

Twp. ~~Pool~~
Co. ~~Face~~

S-513-B

County Seward Elev. 2866 of 3867
 Sec. 16 Twp. 34 Rge. 33W
 Company C. S. O.
 Farm Name Salley "S" "C" No. 72

TOPS	DEPTH	LOG	DATUM
Anh.			
Tp.			
H.		4305	
Tr.	4311	4334	
Dg.			
B.L.			
L.	4507	4445	
K.C. <u>M&M</u>	5158	5206	
B.K.C. <u>M&M</u>	5772	5906	
Ce. <u>M&M</u>		60	
C. <u>cc</u>		6050	
M.	6042		
M.			
K.			
Mz.			
Mq.			
V.			
S.			
S.			
A.			
R.			
Pf.			
G.			
T.D.	6044		

Loc. in Sec. C NE SW
 Geol. _____
 Contr. _____
Holme Drlg.
 Pool Salley
Wildcat

COMPLETE
 JUN 6 '58

Date Comm. 5-27-58 6100' test.
MIRT JUN 3 '58 Ø 1430 JUN 11 '58 8" 2794
Ø 4032 JUN 18 '58 Ø 31 4312 - 35 sp. 30
1" M BHP Ø DST 4337 - 86 sp. 1 hr
9 1/7" 240 m/f 160" 130' gem
360' M & g caw 90' g caw FPTA -
179 BHP 1272 Ø 5287 JUN 25 '58 DST
6029-45. 1 hr 5 M Ø 4440 FP 85
85 BHP 310 Ø 6110 JUL 2 '58
5" 4475 JUL 9 '58 CO 4447

FORK #124 SUNDAY

20/4402 - 06 N.S. 250A 15

P.B. 4394 50/4376-86 1250

A 9260 mcf + 39 Aw pl 1st 1/2

JUL 18 '58

(A) 7hr Blo Down

5000 mcf Igw per mcf

59 4776-86 Co 4394

25/4378 - 83 124 (A)

87770 6000 mcf / 60" 124

51 ~~4378~~

JUL 23 '58

5 mcf

(A) 4338-42 (A) 300

mcf 12 hrs

JUL 30 '58

AUG 5 '58

20' op fl

970 MCF + 179 w 20' vis

59 (A) 4 point BACK PRESS

2450 wet 51P 1144

TR 4338-42

P.B. 4359

16-34-33W

CRESW