

Morton


KANSAS

SECTION 16 TOWNSHIP 34 RANGE 43W

WELL NO. #0-1 Interstate "C"

COMPANY Panhandle Eastern

NORTH C NE SW

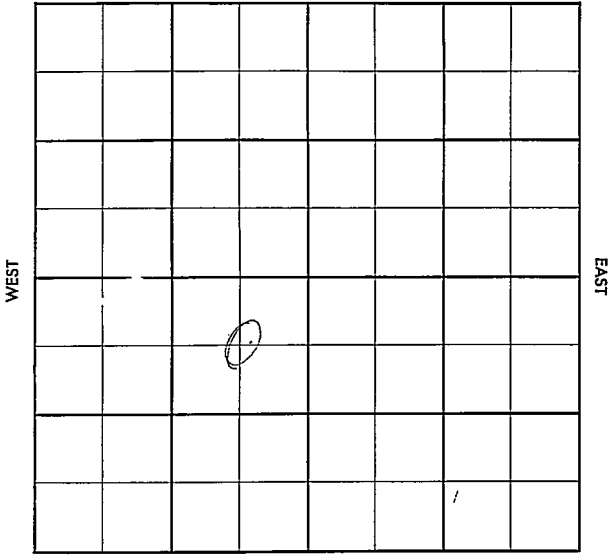

SOUTH

County Norton Elev. _____
 Sec. 16 Twp. 34 Rge. L3W
 Company Panhandle Eastern
 Farm Name Interstate "C" No. 0-1

TOPS	DEPTH	LOG	DATUM	Loc. in Sec.
Anh.				C NE SW
Tr.				
H.				
Tr.				
Dg.				
Bl.				
L.				Geol. _____
K.C.				Contr. _____
B.K.C.				<u>Nye & Snell</u>
Ce.				
C.				Pool _____
M.				<u>Interstate</u>
M.				
K.				
Mz.				
Mo.				
V.				
S.				
S.				FIRST REPORT
A.				
R.				
Pe.				
G.				
T.D.				

o
 MAR 20 57

Date Comm. 3-13-57

7" @ 1207/800

d.l.r.g 2540

~~34~~

Co.
Lse.
No.
Sec.
T.
R.

County Norton Elev. 3523
 Sec. 16 Twp. 34 Rge. 13W
 Company Panhandle Eastern
 Farm Name Interstate "C" No. 0-1

TOPS	DEPTH	LOG	DATUM	Loc. in Sec.						
Anh. <u>W26</u>		<u>2518</u>		C NE SW						
Tr.		<u>2725</u>								
H.										
Tr.										
Dg.										
Bl.										
L. <u>C50</u>		<u>2968</u>		Geol.						
K. <u>C59</u>		<u>3157</u>								
B.K.C.				Contr.						
Ce.		<u>3847</u>								
C.				Nye & Snell						
M. <u>MW 5h</u>		<u>4158</u>								
M. <u>" 5d</u>		<u>4198</u>		Pool						
K. <u>" 5d</u>		<u>4228</u>								
Mz.				Interstate						
Mo.										
V. °				<table border="1"> <tr> <td colspan="2">COMPLETE</td> </tr> <tr> <td>0</td> <td></td> </tr> <tr> <td>MAY 29 '57</td> <td></td> </tr> </table>	COMPLETE		0		MAY 29 '57	
COMPLETE										
0										
MAY 29 '57										
S.										
S.										
A.										
R.										
PE.										
G.										
TD.	<u>4345</u>									

Date Comm. 3-13-57

7" @ 1207/800 dir. # 2510 MAR 27 '57

APR 3 '57 4 1/2 4327 / 150 APR 10 '57

CO 16 / 4230-34 FU. oil

no/w 20 / 4201-06 est Flow

20 Boph no/w FRAC. 3x 1/2

Ran 169 5.1. APR 17 '57 APR 24 '57 MAY 1 '57

MAY 8 '57 MAY 15 '57 MAY 22 '57 MAY 29 '57 p. 256

Bopd no/w 24 hrs

Co.
Sec.
No.
Sec.
T.
R.