


Section 16 Township 34 Range 43W

Well No. #C-05 Interstate

Company P E PL

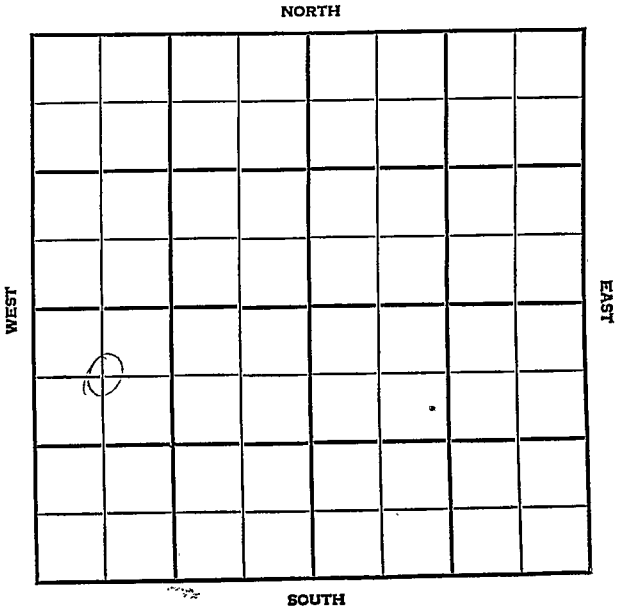

County Morton Elev. _____
 Sec. 16 Twp. 34 Rge. 43W
 Company PEPI
 Farm Name Interstate No. #C05

TOPS /	DEPTH	LOG	DATUM	Loc. in Sec.
Anh.				C NW SW
Tp.				
H.				
Tr.				
Dg.				
Bl.				
L.				Geol. _____
K.C.				Contr. _____
B.K.C.				
Ce.				Ive & Snell Tool
C.				
M.				Pool
K.				Interstate
Mz.				
Me.				
V.				
S.				FIRST REPORT
S.				
A.				
R.				
PE.				
G.				
T.B.				

Date Comm. 12-2-56
10" @ 123 w/100, WOC

34

Co.
No.
Sec.
T.
R.

County Morgan Elev. 3529
 Sec. 16 Twp. 34 Rge. 43W
 Company PEPL
 Farm Name Interstate No. #005

TOPS /	DEPTH	LOG	DATUM	Loc. in Sec.																
Anh. <u>wab</u>		<u>2518</u>		<u>C NW SW</u>																
Tr.		<u>2720</u>																		
H.																				
Tr.																				
Dg.																				
Bl.																				
L. <u>CSO</u>		<u>2962</u>		Geol.																
K.C. <u>LS9</u>		<u>3144</u>																		
K.K.C.				Contr.																
Ce.		<u>3835</u>																		
C.				<u>Wye & Snell T</u>																
M. <u>Mw sh</u>		<u>4138</u>																		
M. <u>Purdy</u>		<u>4182</u>		Pool																
K.																				
Mz.				<u>Interstate</u>																
Mo.																				
V.				<table border="1"> <tr> <td colspan="2"><u>COMPLETE</u></td> </tr> <tr> <td></td> <td></td> </tr> <tr> <td></td> <td></td> </tr> <tr> <td></td> <td></td> </tr> <tr> <td></td> <td></td> </tr> <tr> <td></td> <td></td> </tr> <tr> <td></td> <td></td> </tr> <tr> <td></td> <td><u>JAN 23 '57</u></td> </tr> </table>	<u>COMPLETE</u>															<u>JAN 23 '57</u>
<u>COMPLETE</u>																				
	<u>JAN 23 '57</u>																			
S.																				
S.																				
A.																				
R.																				
PE																				
G.																				
T.D.	<u>4300</u>																			

Date Comm. 12-2-56
10" @ 123 w/100, WCC DEC 12 '56 7" @ 117.9
1750 @ 3100 DEC 19 '56 Rn9 Log
DEC 26 '56 9 1/2 4299 / 200 CO 80 /
4199-4214 Flwd 75 Bopd
no time T&R JAN 2 '57 JAN 9 '57
JAN 15 '57 JAN 23 '57 57 P. P. 481
Bopd. no/wt 9 raw. 41°