


Map No. KANSAS Sec. 16 Twp. 34 R. 38w

Well No. 17 Kelly Farm
Walter Sidwell et al
Company

NORTH

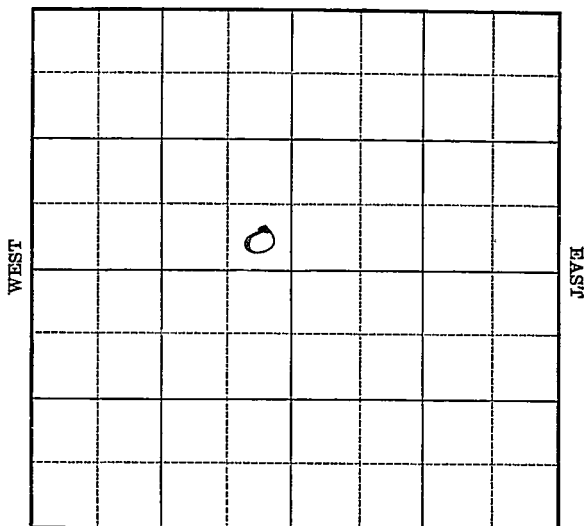

SOUTH

Location_____

Drilling Remarks

Rig Up

Drilling Remarks

RECORD

Cased _____ in. _____ ft.

Sand _____

Gas

Oil

Total Depth_____

PRODUCTION

1st 24 hrs. Nat. _____

1st 24 hrs. after shot_____

Gas _____ cu. ft.

Dry Hole_____

Abandoned _____

52A-5M-27A25
KANSAS

Map No. _____ Sec. 16 Twp. 34 R. 38W

Well No. 1-Kelly Farm _____

Walter Sidwell etal
 Company


NORTH

_____ Ft. from N. Line

330 Ft. from S. Line

330 Ft. from E. Line

_____ Ft. from W. Line

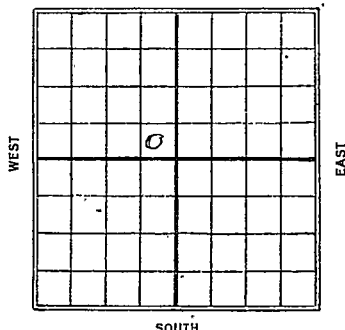

SOUTH

1928

Date

REPORT

<u>6/13</u>	<u>R.O.G.</u>
<u>6/20</u>	<u>Bldg rig</u>
<u>6/27</u>	<u>Spud</u>
<u>7/3</u>	<u>No report</u>
<u>7/11</u>	<u>Spud & S.D.</u>
<u>7/18</u>	<u>Spud 250</u>
<u>7/25</u>	<u>Spud 350</u>
<u>8/1</u>	<u>Drlg 435</u>
<u>8/7</u>	<u>" 550</u>
<u>8/15</u>	<u>No report</u>
<u>8/22</u>	<u>Drlg 630'</u>
<u>9/5</u>	<u>T.D. - 731 V/R 10"</u>
<u>9/12</u>	<u>No report</u>
<u>9/19</u>	<u>T.D. 731 - Fighting quick sand</u>
<u>9/26</u>	<u>Drlg 1100'</u>
<u>10/3</u>	<u>No report</u>
<u>10/10</u>	<u>S.D. 1160' - T.D.</u>
<u>10/17</u>	<u>_____</u>
<u>10/24</u>	<u>_____</u>
<u>10/31</u>	<u>No report</u>
<u>11/7</u>	<u>SD 1160 T.D.</u>

11/14 - SD 1160' T.D. L.S.

11/21 _____

11/28 _____ 12/11 _____

12/5 _____

12/12 _____

12/19 _____

12/26 _____

1929 _____

1/2 _____

1/9 _____

1/16 _____

1/23 _____

1/30 _____

2/6 _____

2/13 - Plyaut 1160' T.D.

2/20 - drly 1310'

2/27 _____

3/6 - no report

3/13 - fsg 1310'

3/20 _____

3/27 - No report

4/3 _____

4/10 _____

4/17 _____

4/24 _____

5/1 _____

5/8 _____

5/15 _____

5/22 _____

5/29 _____

6/5 _____

6/12 _____

6/19 _____

6/26 - fsg 1210

7/2 _____

7/10 _____

7/17 _____

7/24 _____

7/31 - fsg 1310

8/7 _____

8/14 _____

8/21 _____

8/28 - no report

9/4 _____

9/11 _____

9/18 _____

9/25 _____

10/2 _____

10/9 _____

10/16 _____

10/23 _____

10/30 _____

11/6 - fsg 1310'

11/13 _____

11/20 _____

11/27 - no report




Form 252A-5M-11-29-38055

Map No. _____ Sec. 16 Twp. 34 R. 38^w

Well No. 1- Kelly Farm _____

Walter Sidwell et al Company _____

NORTH

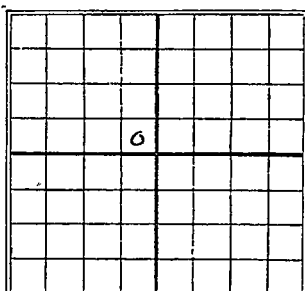

_____ Ft. from N. Line

330 Ft. from S. Line

330 Ft. from E. Line

_____ Ft. from W. Line

SOUTH

Date 1929 Aug 13/10 REPORT

12/18 No report

12/23 _____

12/30 T.D. 1310' Run

1930 _____

1/8 _____

1/15 No report

1/22 True clean 1310'

1/29 Will drill ahead

2/5 S.D. 1310'

2/12 _____

2/19 _____

2/26 _____

3/5 _____

3/12 _____

3/19 _____

3/26 _____

4/2 _____

4/9 _____

4/16 _____

4/23 _____

4/30 _____

6/25 Sig. out
1365'

7/2 _____

7/9 _____

7/16 _____

7/23 - Shut down 1365'
May skid rig

7/30 —

8/6 —

8/13 - Shut down -

8/20 —

8/27 —

9/3 —

9/10 —

9/17 - TD. 1365

dry & abandon

1930 OWDD

12/30 - Old TD. 1365

RUR

1931

1/7 —

1/14 —

1/21 —

1/28 - dreg 1479

2/4 - " 1905'

2/11 - " 2165

2/18 - TD. 2165' Cem cave

2/25 - dreg 2235'

3/4 - " 2633'

3/11 - TD. 2651' lay 5"

3/18 - Cem 5" - 2650'

3/25 - TD. 2651' Cly out

4/8 - TD. 2872'

3 At Gas
Comp.

Map No. KANSAS Sec. 16 Twp. 24 R. 38 WWell No. 1 KellyWalter Sillwell et al Company

Contractor

SECTION PLAT

----- Ft. from N. Line

330 Ft. from S. Line330 Ft. from E. Line

----- Ft. from W. Line

FIRST REPORTS

Location -----

Rig up -----

Drilling and Remarks:

ROG.

RECORD

Cased ----- in., ----- ft.

Sand -----

Gas -----

Oil -----

Total Depth -----

PRODUCTION

1st 24 hrs. Nat. -----

1st 24 hrs. after shot -----

Gas ----- Cu. Ft.

Dry Hole -----

Abandoned -----

Date

JUN 13 1928S. J. LEWIS Scout

no small maps

no wall map

Returned	
Cards	<i>mm</i>
Tracing	<i>none</i>
France Map	
Scarborough Map	
Moody Map	
Scarborough Plat Book	
Moody Plat Book	

Map No. 26000 **KANSAS** Sec. 16 Twp. 34 R. 37W

Well No. 1151129

Walter B. Lewis & Co. Company

Contractor

SECTION PLAT

 Ft. from N. Line

330 Ft. from S. Line

330 Ft. from E. Line

 Ft. from W. Line

ABANDONED

Location

Rig up

Drilling and Remarks:

RECORD

Cased in., ft.

Sand

Gas

Oil

Total Depth 1965

PRODUCTION

1st 24 hrs. Nat.

1st 24 hrs. after shot

Gas Cu. Ft.

Dry Hole

Abandoned

Date

SEP 17 1936 S. J. LEWIS Scout



Returned	
Cards	<i>[Signature]</i>
Tracing	X
France Map	X
Scarborough Map	X
Moody Map	X
Scarborough Flat Book	
Moody Pet Book	

Map No. KANSAS Sec. 16 Twp. 34 R. 38WWell No. 1 TE 14Sidwell & Co Company

Contractor

SECTION PLAT

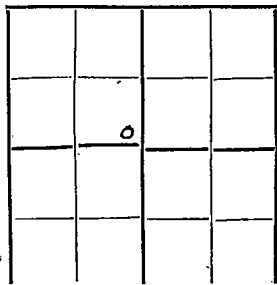

Ft. from N. Line

380 Ft. from S. Line380 Ft. from E. Line

Ft. from W. Line

OW □ □

Location

Rig up

Drilling and Remarks:

O.T. 1365Rigging up
Hokey

RECORD

Cased.....in.,ft.

Sand.....

Gas.....

Oil.....

Total Depth.....

PRODUCTION

1st 24 hrs. Nat.....

1st 24 hrs. after shot.....

Gas.....Cu. Ft.

Dry Hole.....

Abandoned.....

Date

DEC 30 1930

192

S. J. LEWIS

Scout

no longer
no more

Returned	
Cards	
Tracing	X
France Map	X
Scarborough Map	X
Moody Map	X
Scarborough Plot Book	
Moody Pl. & Profile	

Map No. KANSAS Sec. 16 Twp. 34 R. 38^W

Well No. 1 Kelly

Sidwell et al Company

Contractor

COMPLETE

SECTION PLAT

Ft. from N. Line

330 Ft. from S. Line

330 Ft. from E. Line

Ft. from W. Line

	0		

Location

Rig up

Drilling and Remarks:

RECORD

Cased in., ft.

Sand

Gas

Oil

Total Depth 2872

PRODUCTION

1st 24 hrs. Nat.

1st 24 hrs. after shot

Gas 3 AT Cu. Ft.

Dry Hole

Abandoned

Date

APR 8 1931

192

CHAS. L. SHERWOOD

Scout

no wool

Returned	<i>KB</i>
Cards	<i>X</i>
Tracing	<i>X</i>
France Map	<i>X</i>
Scarborough Map	<i>X</i>
Moody Map	<i>X</i>
Scarborough Plat Book	
Moody Plat Book	