

Prod

SIDE ONE

STATE CORPORATION COMMISSION OF KANSAS  
OIL & GAS CONSERVATION DIVISION  
RECOMPLETION FORM  
ACO-2 AMENDMENT TO WELL HISTORY

API NO. 15- 033-20,809-A

County Comanche County, Kansas

C NW NE Sec. 3 Twp. 34S Rge. 17 XXX East West

4620 Ft. North from Southeast Corner of Section

660 Ft. West from Southeast Corner of Section  
(NOTE: Locate well in section plat below.)

Lease Name Meadows "OWWO" Well # R-1

Field Name SE Beals

Producing Formation Mississippian

Elevation: Ground 1816 KB 1828

Operator: License # 5225

Name: Quinque Operating Company

Address: P. O. Box 2738

City/State/Zip: Liberal, KS 67905

Operator: Trident NGL

Operator Contact Person:  
Phone: (316) 624-2578

Designate Type of Original Completion  
 New Well  Re-Entry  Workover

Date of Original Completion 2-10-91

Name of Original Operator Raydon Exploration, Inc.

Original Well Name Meadows R-1


Date of Recompletion:  
9-27-91 12-4-91  
Commenced Completed

Re-entry  Workover

Designate Type of Recompletion/Workover:  
 Oil  SWD  Temp. Abd.  
 Gas  Inj  Delayed Comp.  
 Dry  Other (Core, Water Supply, etc.)

Deepening  Re-perforation  
 Plug Back 5125 PBDT  
 Conversion to Injection/Disposal

Recompleted production:  
 Commingled Docket No. \_\_\_\_\_  
 Dual Completion Docket No. \_\_\_\_\_  
 Other (Disposal or Injection?) Docket No. \_\_\_\_\_

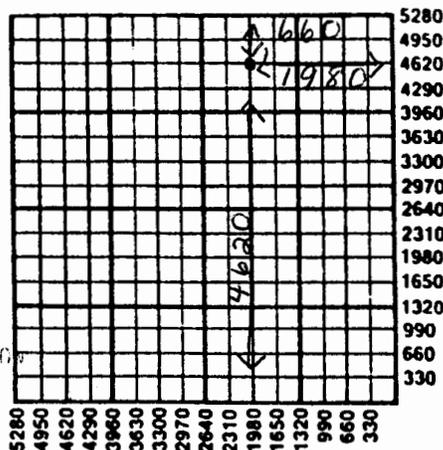

REENTRY 97  
3-13-98

K.C.C. OFFICE USE ONLY  
F  Letter of Confidentiality Attached  
C  Wireline Log Received  
C  Drillers Timelog Received  
Distribution  
 KCC  SWD/Rep  NGPA  
 KGS  Plug  Other (Specify)


INSTRUCTIONS: This form shall be completed in triplicate and filed with the Kansas Corporation Commission, 200 Colorado Derby Building, Wichita, Kansas 67202, within 120 days of the recompletion of any well. Rules 82-3-107 and 82-3-141 apply. Information on side two of this form will be held confidential for a period of 12 months if requested in writing and submitted with the form. See rule 82-3-107 for confidentiality in excess of 12 months. One copy of any additional wireline logs and driller's time logs (not previously submitted) shall be attached with this form. Submit ACO-4 or ACO-5 prior to or with this form for approval of commingling or dual completions. Submit CP-1 with all plugged wells. Submit CP-111 with all temporarily abandoned wells. NOTE: Conversion of wells to either disposal or injection must receive approval before use; submit form U-1.

All requirements of the statutes, rules and regulations promulgated to regulate the oil and gas industry have been fully complied with and the statements herein are complete and correct to the best of my knowledge.

Signature [Signature] Title President Date 1-27-92

Subscribed and sworn to before me this 27th day of January 19 92

Notary Public Beverly A White Date Commission Expires 11-27-95

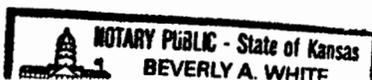

SIDE TWO

Operator Name Quinque Operating Company Lease Name Meadows Well # R-1

Sec. 3 Twp. 34 Rge. 17  East  West

County Comanche County, KS

RECOMPLETION FORMATION DESCRIPTION

Log  Sample

Name	Top	Bottom
Mississippian	5086	5576

ADDITIONAL CEMENTING/SQUEEZE RECORD

Purpose:	Depth		Type of Cement	# Sacks Used	Type and Percent Additives
	Top	Bottom			
<input checked="" type="checkbox"/> Perforate	5008	5105	50-50 POZ	125	12% Salt; 6% Halad 322
<input type="checkbox"/> Protect Casing					
<input type="checkbox"/> Plug Back TD					
<input type="checkbox"/> Plug Off Zone					

Shots Per Foot	PERFORATION RECORD		Acid, Fracture, Shot, Cement Squeeze Record (Amount and Kind of Material Used)
	Specify Footage of Each Interval Perforated		
2	5008	5011	500 gal 15% FE
2	5090	5095	500 gal 15% FE; 4000 gal. MOD 202
2	5136	5138	1500 gal 15% FE

PBTD 5130 Plug Type Cement Retainer

TUBING RECORD

Size 2 3/8 Set At 5125 Packer At N/A Was Liner Run  Y  N

Date of Resumed Production, Disposal or Injection test date 1-10-92

Estimated Production Per 24 Hours Oil 3 Bbls. Water 15 Bbls. Gas-Oil-Ratio  
Gas 500 Mcf

Disposition of Gas:

Vented  Sold  Used on Lease (If vented, submit ACO-18.)