

Section 17 Township 34 Range 10WWell No. #1 Page \_\_\_\_\_Company Jones, Shelburne & Pellow

NORTH

|  |  |  |  |  |  |  |   |
|--|--|--|--|--|--|--|---|
|  |  |  |  |  |  |  | 0 |
|  |  |  |  |  |  |  |   |
|  |  |  |  |  |  |  |   |
WEST

EAST

SOUTH

|            |            |           |
|------------|------------|-----------|
| SEC.<br>17 | TWP.<br>34 | R.<br>10W |
|------------|------------|-----------|

WELL NO.

1 Page

FARM

COMPANY

Jones, Shelburne &amp; Pellow

CONTRACTOR

Transit


Wildcat

330' \_\_\_\_\_ Ft. from N. Line

\_\_\_\_\_ Ft. from S. Line

330' \_\_\_\_\_ Ft. from E. Line

\_\_\_\_\_ Ft. from W. Line

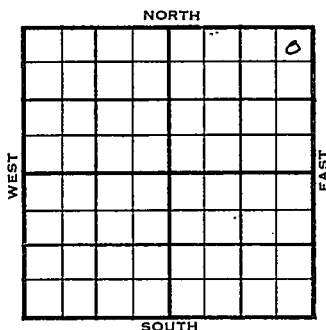

NE NE NE

Continental DHM

| 1955 | ELEVATION   | REPORT   |
|------|---|---|
|      | 1389'   |   |
| 5/25 | Spud 5-23-55<br>8" @ 219<br>WOC   |   |
| 6/22 | Comm 5-23-55<br>Elgin 3439<br>H 3619<br>Tr 3641<br>Dg 3664<br>L 4026<br>Stal 4043<br>KC 4184<br>M 4680<br>K<br>Chatta<br>Mq 5033<br>V 5054<br>S 5135<br>A 5331<br>TD 5361<br>8" @ 219/150 DST 4674-91 open 1<br>hr gas in 8 min. 100 mcfg Rec 70'<br>gcm 1575/30" DST 4690-4713 open<br>1 hr gas in 59 min. Rec 60' gcm<br>1600/30" DST 5121-51 open 1½ hr<br>Rec 180' gcm 110/30"<br>D & A | 3442<br>3621<br>3640<br>3668<br>4028<br>4038<br>4187<br>4679<br>4946<br>4997<br>5021<br>5047<br>5133<br>5331 |



County Barber Elev. 1389  
 Sec. 17 Twp. 34 Rge. 10W  
 Company Jones, Shelburne & Pellow  
 FarmName Page No. 1

| TOPS              | DEPTH       | LOG         | DATUM       |
|-------------------|-------------|-------------|-------------|
| Anh.              |             |             |             |
| Tp. <u>Elgin</u>  | <u>3439</u> | <u>3442</u> | <u>2053</u> |
| H.                | <u>3619</u> | <u>3621</u> | <u>2232</u> |
| Tr.               | <u>3684</u> | <u>3640</u> | <u>2251</u> |
| Dg.               | <u>3664</u> | <u>3668</u> | <u>2279</u> |
| Bl.               |             |             |             |
| L.                | <u>4026</u> | <u>4028</u> | <u>2639</u> |
| Fe. <u>Stal</u>   | <u>4043</u> | <u>4038</u> | <u>2649</u> |
| B.K.C.            | <u>4184</u> | <u>4187</u> | <u>2798</u> |
| Ce.               |             |             |             |
| C.                |             |             |             |
| M.                | <u>4680</u> | <u>4679</u> | <u>3290</u> |
| M.                |             |             |             |
| K.                |             | <u>4946</u> | <u>3551</u> |
| Mz. <u>Chatta</u> |             | <u>4997</u> | <u>3608</u> |
| Mo.               | <u>5033</u> | <u>5021</u> | <u>3632</u> |
| V.                | <u>5054</u> | <u>5047</u> | <u>3658</u> |
| S.                | <u>5135</u> | <u>5133</u> | <u>3744</u> |
| S.                |             |             |             |
| A.                | <u>5331</u> | <u>5331</u> | <u>3942</u> |
| R.                |             |             |             |
| Pe.               |             |             |             |
| G.                |             |             |             |
| T.D.              | <u>5361</u> |             |             |

Loc. in Sec. NE NE NE

Geol.

Contr.

Transit

Pool

Wildcat

ABANDONED

Date Comm. 5-23-55

JUN 22 1955

8" @ 219/150 DST 4674-91 open 1 hr.

gas in 8 min. 100 mcfg Rec. 70' gcm

1575/30" DST 4690-4713 open 1 hr.

gas in 59 min. Rec. 60' gcm 1600/30"

DST 5121-41 open 1 $\frac{1}{2}$  hr. Rec. 180' gcm

110/30"

D & A