

Barber

KANSAS

SECTION 17 TOWNSHIP 34 RANGE 12


WELL NO. #1 Robt. B. Cook "B"

COMPANY Magnolia Pet.

NORTH

WEST

EAST

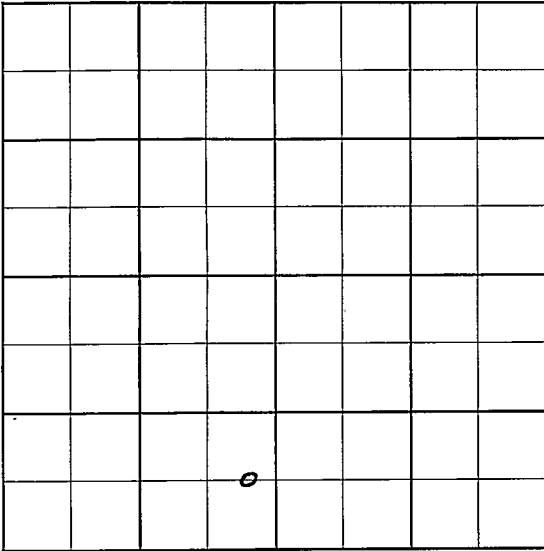

SOUTH

Barber

KANSAS

SEC.

TWP.

R.

17-

34-

12W

WELL NO.

#1 Robert B. Cook "B"

FARM

COMPANY

Magnolia Petr.

CONTRACTOR

Bass Drlg.


Hardtner

Ft. from N. Line

Ft. from S. Line

Ft. from E. Line

Ft. from W. Line

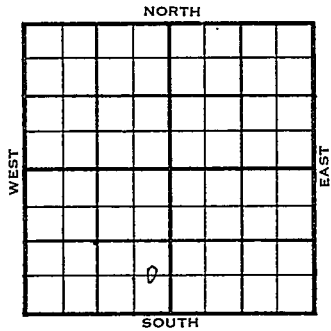C E $\frac{1}{2}$ SE SW

1956

ELEVATION

REPORT

1-25

RUR

County Barber Elev. _____
 Sec. 17 Twp. 34 Rge. 12W
 Company Magnolia Pet.
 Farm Name Robt. B. Cook "B" No. 1

TOPS	DEPTH	LOG	DATUM
Anh.			
Tr.			
H.			
Tr.			
Dg.			
BL.			
L.			
K.C.			
B.K.C.			
Ce.			
C.			
M.			
M.			
K.			
Mz.			
Ma.			
V.			
S.			
S.			
A.			
R.			
Pe.			
G.			
T.D.			

Loc. in Sec. C E $\frac{1}{2}$ SE SW

Geol. _____
 Contr. Bass Drlg.

Pool Hardtner

JAN 25 '51
 FIRST REPORT
 o

Date Comm. RUR

[Handwritten signature]

Co.

Lse.

No.

Sec.

T.

R.

JAN 31 1956

R. G.

70

County Barber Elev. 1522
 Sec. 17 Twp. 34 Rge. 12W
 Company Magnolia Pet.
 Farm Name W. B. Cook "B" No. 1

TOPS	DEPTH	LOG	DATUM	Loc. in Sec.
Ant.				C E $\frac{1}{2}$ SE SW
Tp.				
H.		3828	2306	
Tc.		3855	2333	
Dp.		3901	2379	
Bl.		4046	2524	
L.				
NC		4349	2822	Geol.
REC.				Contr.
Cc.		4728	3206	Bass Drlg.
C.	4741	4740	3218	
M.				Pool
M.				Hardtner
K.				
Ma.				
Me.				
V.				
S.				
S.				
A.				
R.				
FE				
S.				
JA	4850			

COMPLETE

Date Comm.

FEB 22 1956

RUR FEB 1 '56 1-23-56 95/8
 348/300 ϕ 3115 FEB 8 '56 DST
 4740-70 1hr 9 in 11" ga 88
 MCF in 1hr rec 100' SGCM
 FFP 100 BHP 1750/20 DST
 4772-4850 ga 2 1hr rec 31'
 50' SGCM FFP 80 BHP 100/20
 ϕ 4850 FEB 15 '56 5 1/2 4849/150
 Co 88/4744-74 1/2 FWD

MAR 1 1956

R. G.

BHP 1859#

SITP 1628# CP 1626

8.300 MCFG

22P 800# FEB 22 '56 221 op F/W

15 ha 1/4" 2b FTP 1200#

F/W 2.930 MCFG PD + LD in

SITP 1422 CP 1480# F/W

635 MCFG PD + LD in 16 ha