

Barber

KANSAS

SECTION 17 TOWNSHIP 34 RANGE 12 W

WELL NO. #1 Vestal L. Cook

COMPANY Magnolia Pet.

NORTH

						0	

WEST

EAST

SOUTH

Bärber

KANSAS

SEC. 17	TWP. 34	R. 12W
------------	------------	-----------

WELL NO.

#1 Vestal L. Cook

FARM

COMPANY

Magnolia Petr.

CONTRACTOR

G-M-R

Hardtner


_____ Ft. from N. Line

_____ Ft. from S. Line

_____ Ft. from E. Line

_____ Ft. from W. Line

NW NE SE

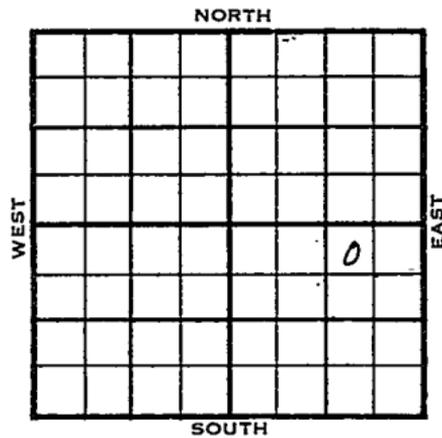

1956

ELEVATION

11497

REPORT

2-29

MIR

3/28

Comm 2-28-56

H

3833

Dg

3885

L

4027

M

4722

4723

TD

4795

9 5/8" @ 357/300

DST 4720-65 open 1 hr rec 45' mud

215/20 5 1/2" @ 4794/150 CO to

4759 116/4727-56 500 A frac

F/225 mcfg 1,750 mcfg

Comp open flow 5,350 mcfgpd

COMPLETED

4-4

ADDITIONAL INFORMATION:

Correcting potential to:

2,050,000 cfpd.

COMPLETED

County Barber Elev. _____
 Sec. 17 Twp. 34 Rge. 12W
 Company Magnolia Pet.
 FarmName Vestal L. Cook No. 1

TOPS	DEPTH	LOG	DATUM
Anh.			
Tp.			
H.			
Tr.			
Dg.			
Bl.			
L.			
K.C.			
B.K.C.			
Ce.			
C.			
M.			
M.			
K.			
Mz.			
Mq.			
V.			
S.			
S.			
A.			
R.			
Pe.			
G.			
T.D.			

Loc. in Sec. NW NE SE

Geol. _____
 Contr. G-M-R

Pool Hardtner

FIRST REPORT
 FEB 29 '56

Date Comm. MIR

~~26~~

Co.
Lse.
No.
Sec.
T.
R

MAR 7 1956

R. G.

APR 1 8 1956

R. G.

County Barber Elev. 1497
 Sec. 17 Twp. 34 Rge. 12W
 Company Magnolia Pet.
 Farm Name Vestal L. Cook No. 1

TOPS	DEPTH	LOG	DATUM
Anh.			
Tp.			
H.		3833	
Tr.			
Dg.		3885	
Bl.			
L.		4027	
K.C.			
B.K.C.			
Ce.			
C.			
M.	4722	4723	3226
M.			
K.			
Mz.			
Me.			
V.			
S.			
S.			
A.			
R.			
PE.			
G.			
T.D.	4795		

Loc. in Sec.

NW NE SE

Geol.

Contr.

G-M-R

Pool

Hardtner

COMPLETE

MAR 28

Date Comm. 2-28-569 5/8" @ 357/300 DST 4720-65open 1 hr. rec. 45' mud 215/205 1/2" @ 4794/150 CO to 4759116/ 4727-56 500 A frac F/ 225 mcfg1,750 mcfg Comp. open flow 5,350 mcfgpd

.. # 4444



APR 6 1956

M. MC.