

Section 17 Township 34 Range 13 WWell No. # 1 BlunkCompany Aylward et al

NORTH

WEST

EAST

SOUTH

Barber

KANSAS

Sec. 17 Twp. 34 R. 13W

Well No. #1 Blunk Farm

Aylward et al Company

Aylward Drlg. Contractor
Wildcat


 Ft. from N. Line

330 Ft. from S. Line

990 Ft. from E. Line

 Ft. from W. Line

SW SE SW

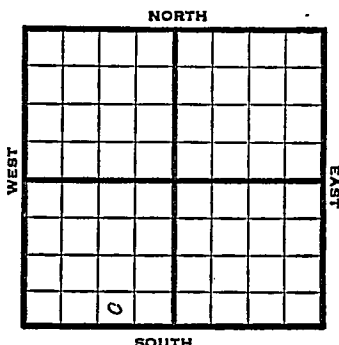

1952 Elev. 1620' REPORT

7/30 Spud 7-22-52
8" @ 200'
Anhy 1145'
Drlg. 2565'

8/6 Lans. 4096
Drlg. 4145

8/13 Miss. 4678
DST 4683-4710, 1 hr. 10' m
Drlg. 4711'


8/20 Drlg. 5232

8/27 Spud 7-22-52
D&A TD 5250' 8" @ 200'
Anhy 1145' Lans. 4096
Miss. 4678
DST 4683-4710 open 1 hr. rec. 10' mud
315# Tor. 3955 Doug. 4006
Lang. 4096 Miss. 4678
Kh. 4962 Chat 5005
Misener 5057 Sylvian 5064
Viola 5081 Simp. sh 5195
Simp. sd 5223
TD 5250' D&A

ABANDONED

J. G. McGEHEE

County Barber State Kansas
 Sec. 17 (Blk. 34 (Sur. 13W Map No.
 (Twp.) (Rge.)
 Operator Aylward et al.
 Well No. 1 Farm Blunk
 Elev. 1620 Location SW SE SW

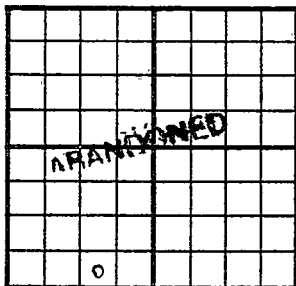

330 Ft. From S Line SW
990 Ft. From E Line Quarter

Ist. Report

Completion AUG 27 1952

Remarks Wildcat

Aylward Drlg. - Contr.

Spudding Date 7-22-52

Drlg. Data D & A TD 5250

8" @ 200 Anhy 1145 Lans. 4096

Miss. 4678 DST 4683-4710 open 1 hr.

Rec. 10' mud 315# Tor. 3955

Doug. 4005 Lans. 4096 Miss. 4678

Kh. 4962 Chat 5005 Misener 5057

Sylvian 5064 Viola 5081 Simp. sh. 5195

Simp. sd. 5223 TD 5250

D & A

J. G. McGEHEE