

KANSAS


FORM 51 25M 3-49 PETROL

Seward

Section 17 Township 34 Range 33-W

Well No. #1 Brown "G"

Company Cities Service

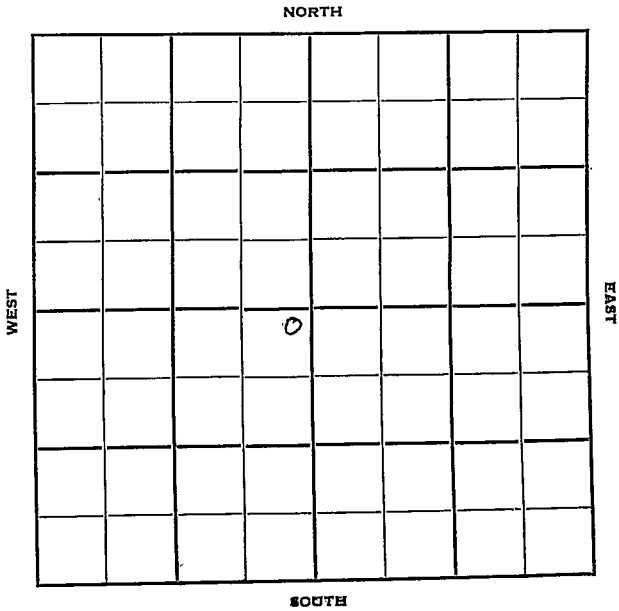

Seward

KANSAS

Sec. 17 Twp. 34 R. 33W

Well No. #1 Brown "C" Farm

Cities Service

Company

Contractor

Hugoton Pool

NORTH

150'

Ft. from N. Line

Ft. from S. Line


150'

Ft. from E. Line

Ft. from W. Line

WEST

EAST

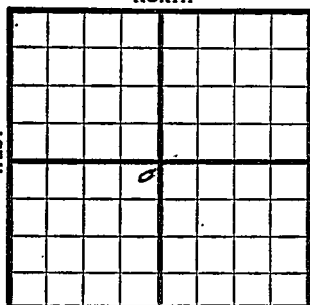

SOUTH

NE SW

1950

Elev 2875 REPORT

9/20

8" @ 680' Spud 9-12-50

TD 2780'

5" @ 2779'

11/29

Spud 9-12-50

8" @ 680

5" @ 2779

Her 2618

Krider 2644

Win 2732

CO to 2743

80/2730-38 120/2674-2704 84/2646-60

48/2620-28 36/2610-16 14300 A

Comp 11,300,000 gas 420#

TD 2780

Completed

COMPLETED

J. E. TYRA

County Seward State Kansas

Sec. 17 (Blk. Twp.) 34 (Sur. Rge.) 33W Map No.

Operator Cities Service

Well No. 1 Farm Brown "C"

Elev.	2875	Location	NE SW
-------	------	----------	-------

150 Ft. From N Line SW

150 Ft. From E Line Quarter

1st. Report

Completion **NOV 29 1950**

Remarks	Hugoton Pool
---------	--------------

Spudding Date 9-12-50

Drlg. Data Gas well TD 2780

8" C 680 5" C 2779 Her. 2618

Krider 2644 Win. 2732 CO to 2743

80/ 2730-38 120/ ~~2674-2704~~ 84/ 2646-60

48/ 2620-28 36/ 2610-16 14300 A

Comp. 11,300,000 gas 420#

J. E. TYRA