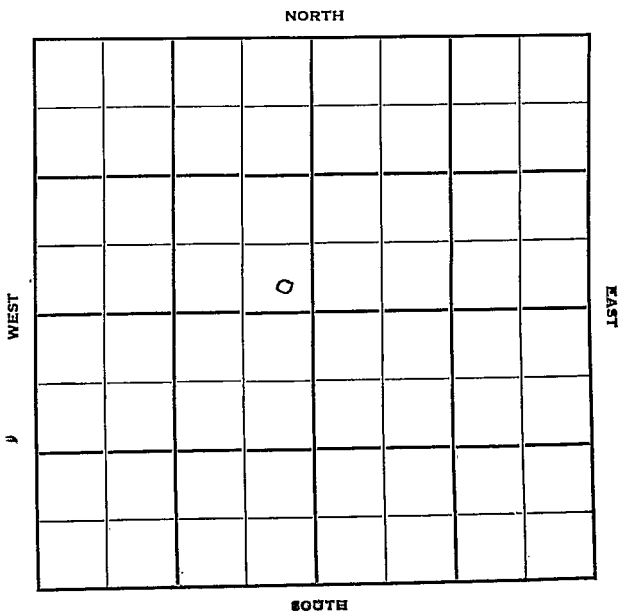


Section 17 Township 34 Range 34WWell No. #1 D. D. HamptonCompany Hugoton Plains

Seward

KANSAS

Sec. 17 Twp. 34 R. 34W

Well No. #1 E. D. Hampton Farm

Hugoton Plains Company

Contractor

Hugoton Pool


Ft. from N. Line

200' Ft. from S. Line

Ft. from E. Line

200' Ft. from W. Line

SE NW

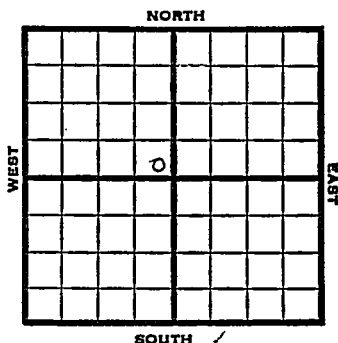

1951

Elev. 2960' REPORT

8/8

Location

9/19

Spd 8-10-51

Gas Well TD 2771

10" @ 698

Her. 2635

Kri 2664

Win. 2751

7" @ 2760

TD 2771

60/2642-52 60/2666-76

270/2694-2739 60/2750-60

17,000 A Comp. 2,340,000 gas

COMPLETED

County **Seward** State **Kansas**

Sec. **17** (Blk. Twp.) **34** (Sur. Rge.) **34W** Map No.

Operator Hugoton Plains

Well No. **1** Farm **D. D. Hampton**

Elev.	Location	SE	NW
-------	----------	----	----

FIRST REPORT

0

200 Ft. From S Line NW

200 Ft. From E Line Quarter

1st Report

Completion

Remarks

Spudding Date _____

Drlg. Data Hugoton Pool

Location

J. E. TYRA

J. E. TYRA