

KANSAS

Stevens County

FORM 51 IOM 12-46 PETROL


Section 17 Township 34 Range 37-WWell No. 1 Don HoffmanCompany Panhandle Eastern

Hugoton Pool

NORTH

WEST

EAST

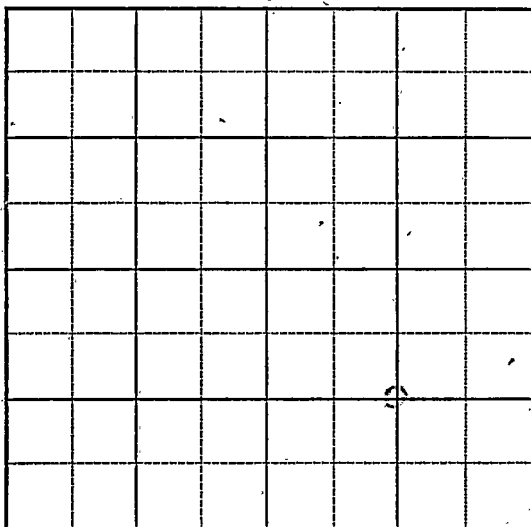

SOUTH

KANSAS

Stevens County

Sec. 17 Twp. 34 R. 37-W

Well No. 1 Don Hoffman Farm

Panhandle Eastern Company


Hugoton Pool

 Ft. from N. Line

1320 Ft. from S. Line

1320 Ft. from E. Line

 Ft. from W. Line

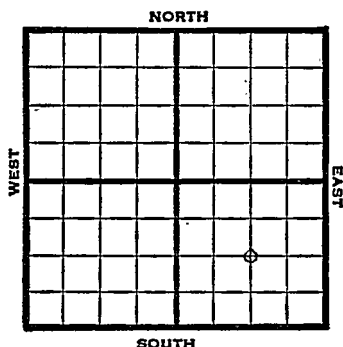

C SE

1947 Elev. 3174: REPORT

7-16 RUR

7/22 10" @ 707
Drlg. 2165

7/29 7" @ 2671'
TD 2695'

8/6 "

8/13 "

8/20 TD 2857'

8/27 "

9/3 "

9/10 "

9/17 7" @ 2671'
195' of 5" Perf. liner @ 2857'
2,434,000 Gas
387# Rock Pressure Nat
Total Depth 2857'

COMPLETED

Map No. _____ Sec. 17 Twp. 34 R. 37W

Well No. 1 Don Hoffman

Panhandle Eastern Company

ELST REPORT Contractor

C SE


SECTION PLAT

_____ Ft. from N. Line

1320 Ft. from S. Line

1320 Ft. from E. Line

_____ Ft. from W. Line

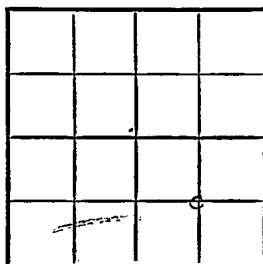

Stevens County

Location _____

Rig up _____

Drilling and Remarks:

R U R

RECORD

Cased _____ in., _____ ft.

Sand _____

Gas _____

Oil _____

Total Depth _____

PRODUCTION

1st 24 hrs. Nat. _____

1st 24 hrs. after shot _____

Gas _____ Cu. Ft.

Dry Hole _____

Abandoned _____

Date

JUL 16 1947

19

S. J. LEWIS

Scout

Map No. 0 Sec. 17 Twp. 34 R. 37W

Well No. 1 Don Hoffman

Panhandle Eastern Company

COMPLETE

Contractor

C SE


E1,3174
SECTION PLAT

 Ft. from N. Line

1320 Ft. from S. Line

1320 Ft. from E. Line

 Ft. from W. Line

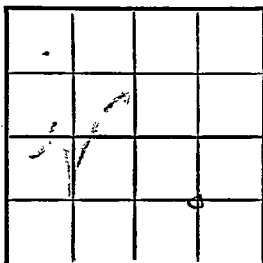

Stevens County

Location

Rig up

Drilling and Remarks:

7" @ 2671

195' x 5" Pay liner

@ 2857

2,434,000 Gas No.

899 # R/A

RECORD

Cased in. ft.

Sand

Gas

Oil

Total Depth 2857

PRODUCTION

1st 24 hrs. Nat.

1st 24 hrs. after shot

Gas Cu. Ft.

Dry Hole

Abandoned

Date

SEP 17 1947 19

S. J. LEWIS Scout