

Morton

KANSAS

17


34

43W

SECTION _____ TOWNSHIP _____ RANGE _____

WELL NO. #1 Government "A"

COMPANY Huber

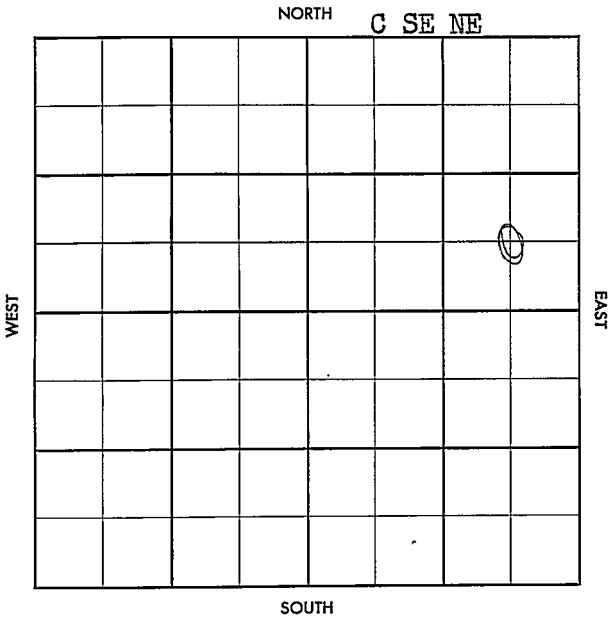

County Morton

Elev. _____

Sec. 17 Twp. 34

Rge. 43W

Company Huber

Farm Name Government "A"

No. 1

TOPS

DEPTH

LOG

DATUM

Loc. in Sec. _____

Anh. _____

C SE NE

Tr. _____

H. _____

Dg. _____

Bl. _____

L. _____

K.C. _____

B.K.C. _____

Ce. _____

C. _____

M. _____

M. _____

K. _____

Mz. _____

Mq. _____

V. _____

S. _____

S. _____

A. _____

R. _____

Pe. _____

G. _____

T.D. _____

Geol. _____

Contr. _____

Holm Drlg.

Pool _____

Interstate

FIRST REPORT

FEB 20 57

Date Comm. To go 2-21-57

Location

34

Co.

Lse.

No.

Sec.

T.

R.

County MortonElev. 3584Sec. 17Twp. 34Rgs. 43WCompany HuberFarm Name Government "A"No. 1

TOPS	DEPTH	LOG	DATUM
Anb.			
Tr.		2783	
H.			
Tr.			
Dg.			
BL.			
L.		3026	
K.C.			
B.K.C. MWSH		4176	
Ce. <u>Purdy</u>		4259	
C.			
M.			
M.			
K.			
Mz.			
Mq.			
V.			
S.			
S.			
A.			
R.			
PE.			
G.			
T.D.	4357	4357	

Loc. in Sec. C SE NEGeol. Contr. Holm Drlg. Pool Interstate

APR 17 '57

0

COMPLETE

Date Comm. To go 2-21-57

Location FEB 27 '57

3-1-57

10 3/4 1275' 7 7 1/8 1480'

1 2665 " 1" " 57' Cld 4279-4312

near 52' (50) 5 1/2 4356' 15"

MICT 27 '57 CO 4328 16' 4310

-14 Flwd 35.5 B0 + 6.9% WTG

30" Flwd 28.5 B0 no/w 20"

40' 4300-10 Flwd 261 B0 no/w

3 hrs @ 15" Ran 789 APR 3 '57 V APR 10 '57

APR 17 '57

Ph BH Bomb Flw
2362 Bofd no/wt
graw 39°