

Morton

KANSAS

SECTION 17 TOWNSHIP 34S RANGE 43W

WELL NO. #0-4 Humble


COMPANY Panhandle Eastern 11/2

NORTH

SE NW

WEST

EAST

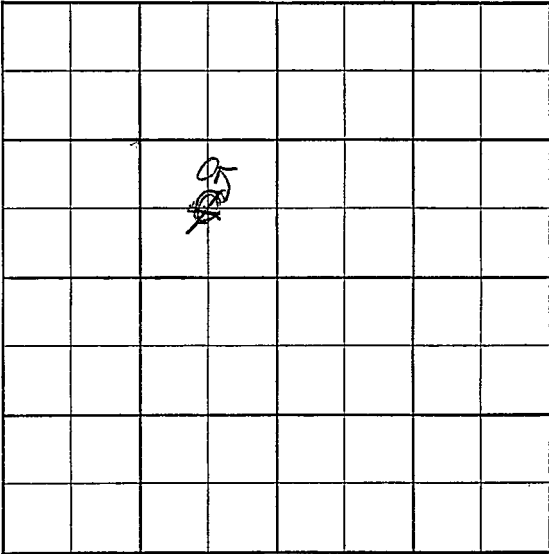

SOUTH

210

County Morton Elev. _____
 Sec. 17 Twp. 34 Rge. 43W
 Company Panhandle Eastern
 Farm Name Humble No. 04

TOPS	DEPTH	LOG	DATUM
Anh.			
Tp.			
H.			
Tr.			
Dg.			
B.L.			
L.			
K.C.			
B.K.C.			
Ce.			
C.			
M.			
M.			
K.			
Mz.			
Mq.			
V.			
S.			
S.			
A.			
R.			
Pf.			
G.			
T.D.			

Loc. in Sec. _____


C SE NW

Geol. _____

Contr. _____

Ward

Pool _____

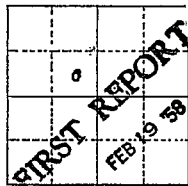Interstate

Date Comm. _____

Location

Co.

Twp.

No.

Sec.

T.

R.

CORRECTION

S-513-B

3558DE

County Morton Elev. 3547 DE 3550 RB
 Sec. 17 Twp. 34 Rge. 43W
 Company Panhandle Eastern
 Farm Name Humble No. 04

TOPS	DEPTH	LOG	DATUM
Anh.		1233	
Tp. <u>W30</u>		2550	
H. <u>TP</u>		2749	
Tr. <u>Grwood</u>		2999	
Dg.			
B.L.			
L.		3170	
K.C.			
B.K.C.			
Ce.		3869	
C. <u>Morsh</u>		4179	
M. <u>Purdy</u>		4240-89	
M.			
K.			
Mz.			
Mq.			
V.			
S.			
S.			
A.			
R.			
Pf.			
G.			
T.D.	<u>4350</u>		

Loc. in Sec.
~~G-SH IN~~
 800' FS 1
 550' FEL
 N1/2 Sec 14W

Geol.
 Contr.
 Ward.

Pool
 Interstate

COMPLETE
 SEP 10 '58

Date Comm. 4-2-58
 Location FLB 26 '58 MAR 5 '58 MAR 12 '58 MAR 16 '58
MAR 26 '58 APR 2 '58 APR 9 '58 7" 1240/1250
Ø 2518 APR 16 '58 Ø 4233 APR 23 '58 Cnd
4246-57 well Cnd 4257-82
rec 24" DST 4247-82 1hr
9 1/16" TSTM rec 3900' 011' 300'
SS14W FP 560-1120 BHP 1140
Cnd 4282-4303 T-C 21
Log 4 1/2 4349/100 wood
APR 30 '58 40 40/ 4252-62 \$9 BOPH

NW 1/4 Sec 16

MAY 7 '58

~~10/1/58~~

MAY 14 '58

MAY 21 '58

MAY 28 '58

JUN 3 '58

JUN 11 '58

JUN 18 '58

JUN 25 '58

JUL 2 '58

JUL 9 '58

JUL 16 '58

JUL 23 '58

JUL 30 '58

AUG 6 '58

AUG 13 '58

AUG 20 '58

AUG 27 '58

SEP 3 '58

SEP 10 '58

State Rt 197 Bopd NW

Sec 39

COR 498 to 1

17-34-43W

N 1/2 SE NW