


Morton

KANSAS

SECTION 17 TOWNSHIP 34S RANGE 43W

WELL NO. #0-5 Interstate "BW"

COMPANY Panhandle Eastern

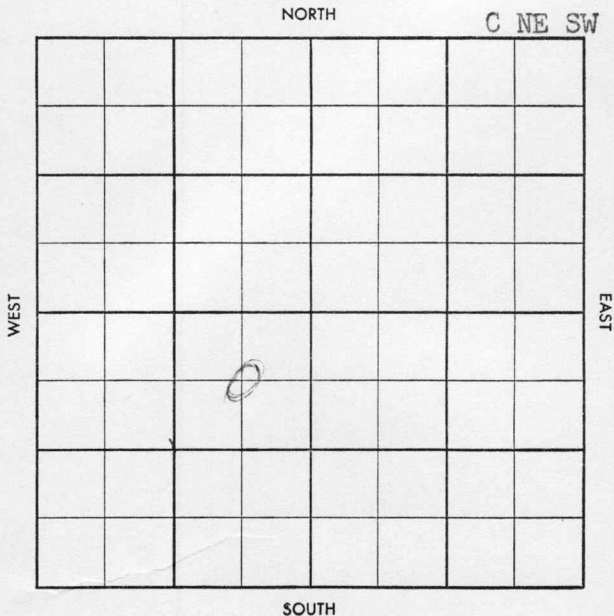

200

County Morton Elev. _____
 Sec. 17 Twp. 34 Rge. 43W
 Company Panhandle Eastern
 Farm Name Interstate "B" No. 05

TOPS	DEPTH	LOG	DATUM
Anh.			
Tp.			
H.			
Tr.			
Dg.			
B.L.			
L.			
K.C.			
B.K.C.			
Ce.			
C.			
M.			
M.			
K.			
Mz.			
Mq.			
V.			
S.			
S.			
A.			
R.			
Pf.			
G.			
T.D.			

Loc. in Sec. _____


C NE SW

Geol. _____

Contr. _____

Ward

Pool _____

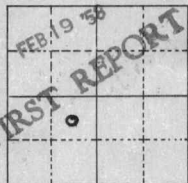Interstate

Date Comm. _____

Location

Co.

Lse.

No.

Sec.

T.

R.

Twp. X Pool X
Co. X Facet X

S-513-B

County Morton Elev. 3535 DP 3538 RB
Sec. 17 Twp. 34 Rge. 43W
Company Panhandle Eastern
Farm Name Interstate "B" No. 05

TOPS	DEPTH	LOG	DATUM
Anh. <u>Wab</u>		<u>2516</u>	
Tp.		<u>2716</u>	
H. <u>Greenwood</u>		<u>2955</u>	
Tr.			
Dg.			
B.L.			
L.		<u>3141</u>	
K.C.			
B.K.C.			
Ce.		<u>3839</u>	
C. <u>morr</u>		<u>4156</u>	
M. <u>Purdy</u>		<u>4241-53</u>	
M.			
K.			
Mz.			
Mq.			
V.			
S.			
S.			
A.			
R.			
Pf.			
G.			
T.D.	<u>4441</u>	<u>4438</u>	

Loc. in Sec. C NE SW

Geol. Ward

Pool Interstate

ABANDONED

APR 9 '58

Date Comm. 3-14-58

Location FEB 26 '58 MAR 5 '58 MAR 12 '58 MAR 19 '58

MAR 26 '58 7" 1240/450 Ø 3605

APR 2 '58 DST 4243-4441 op 60" 60'

508 gmsnw 1355' SW FP 0-600

BHP 1030/50 log APR 9 '58

D-6A