

Morton


KANSAS

SECTION 17 TOWNSHIP 34 RANGE 43W

WELL NO. #5 Govt. "A"

COMPANY Huber

CEP
NORTH 8 NW NW

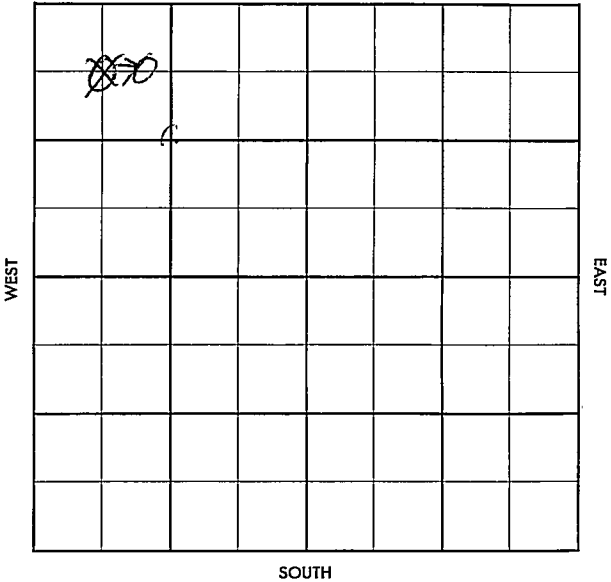

TOPS	DEPTH	LOG	DATUM	Loc. in Sec.
Anb.				C NW NW
TP.				
H.				
Tr.				
Dg.				
Bl.				
L.				Geol.
K.C.				
B.K.C.				Contr.
Ce.				
C.				
M.				
M.				Pool
K.				Interstate
Mz.				
Me.				
V.				
S.				
S.				
A				
R.				
Pe.				
G.				
T.D.				

o

FIRST REPORT

JUL 31 1957

Date Comm.

Location

Co.

Use:

No.

565

1

1

K-20

CORRECTION

FORM 513 SUNRAY

County Morton Elev. 3570

Sec. 17 Twp. 34 Rge. 43W

Company Huber

Farm Name Govt. "A" No. 5

TOPS	DEPTH	LOG	DATUM
Anh.			
TP. <u>elmer</u>		<u>2766</u>	
H. <u>TP</u>		<u>2863</u>	
Tr. <u>comp</u>		<u>3009</u>	
Dg. <u>mo 34</u>		<u>4150</u>	
Bl. <u>purdy</u>		<u>4283-4320</u>	
L.			
K.C.			
B.K.C.			
Ce.			
C.			
M.			
M.			
K.			
Mz.			
Ma.			
V.			
S.			
S.			
A.			
R.			
Pe.			
G.			
TD.	<u>4350</u>	<u>4349</u>	

Loc. in Sec. G NW NW
C E/2 NW NW

Geol. _____
 Contr. CD to 1/8

Pool _____
 Interstate _____

COMPLETE
 OCT 23 '57

Date Comm.

Location AUG 9 '57 AUG 14 '57 AUG 17 '57 AUG 28 '57

SEP 4 '57 LOC SEP 11 '57 SEP 18 '57 SEP 25 '57

OCT 2 '57 SPLD 9.27-57 8

1220/700 TP 28 25 OCT 9 '57

5 1/2" #350/ in log MICT

OCT 16 '57 8/4296-98 EU 2000' oil

now 1 hr 20/4291-96 F16

4380 NW 2 hrs F10 104.80

now 6 hrs *sty OCT 23 '57

PHY + F16 + 21 B0 NW 24 hrs

Purdy 4291-98