


Morton

KANSAS

SECTION 17 TOWNSHIP 34S RANGE 43W

WELL NO. #0-2 Humble

COMPANY Pahhandle Eastern

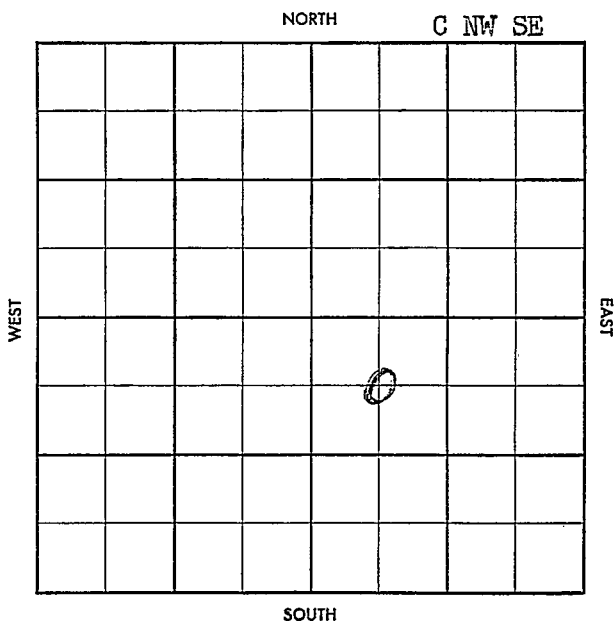

Co.

Use:

No.

FIRST REPORT
FEB 19 1960

Sec.

1.

五

~~Top~~ ~~Pool~~
~~Chamber~~ ~~Foot~~

S-513-B

County Morton Elev 3581 or 3584
 Sec. 17 Twp. 34 Rge. 43W
 Company Panhandle Eastern
 Farm Name Humble No. 02

TOPS	DEPTH	LOG	DATUM
Anh. <u>Wab</u>		<u>2562</u>	
Tp. <u>Greenwood</u>		<u>2764</u>	
H. <u>Greenwood</u>		<u>3000</u>	
Tr.			
Dg.			
B.L.			
L.		<u>3181</u>	
K.C.			
B.K.C.			
Ce.		<u>3274</u>	
C. <u>marsh</u>		<u>4182</u>	
M. <u>Purdy</u>		<u>4234</u>	<u>-86</u>
M.			
K.			
Mz.			
Mq.			
V.			
S.			
A.			
R.			
Pf.			
G.			
T.D.	<u>4340</u>		

Loc. in Sec. C NW SE

Geol.
 Contn. Ward

Pool Interstate

COMPLETE
 AUG 20 '58

Date Comm. 2-27-58 7" 1264/450
 Location 22678 MAR 5 '58 02175 MAR 12 '58
fig MAR 12 '58 Log 4 1/2 4340/100
W OCT MAR 26 '58 CO 4318 32/4250-66
\$16 BOPH NW 3 hrs Tbg 4252
W OCT APR 2 '58 APR 9 '58 APR 16 '58 APR 23 '58 APR 30 '58
MAY 7 '58 MAY 14 '58 MAY 21 '58 MAY 28 '58 JUN 3 '58 JUN 11 '58
JUN 18 '58 JUN 25 '58 JUL 2 '58 JUL 9 '58 JUL 16 '58 JUL 23 '58
JUL 30 '58 AUG 6 '58 AUG 13 '58 AUG 20 '58 Phy P & Fl
81 B.O. NW 24 hrs on 39
Purdy 4250 -66