


Morton

KANSAS

SECTION 17 TOWNSHIP 34S RANGE 41W

WELL NO. #1-17 Lewis 1 B''

COMPANY P.E.P.L.

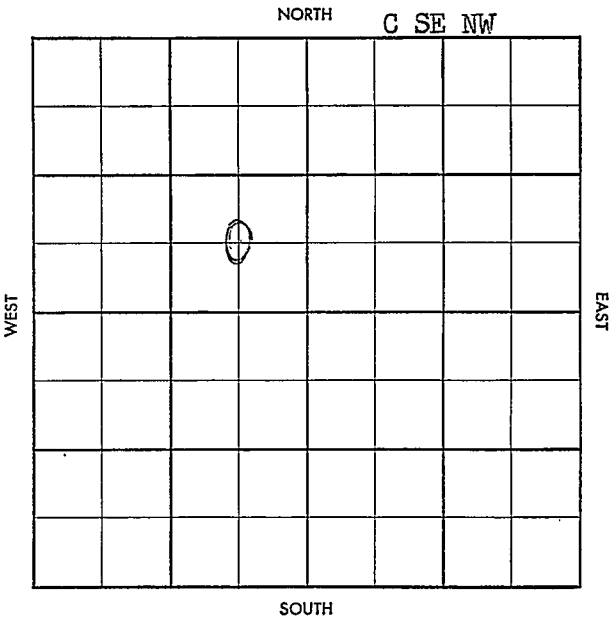

2

CO. Morton ELEV. _____

SEC. 17 TWP. 34 RGE. 41W

COMPANY P.E.P.L. NO. 1-17

DEC 11 37	
0	
FIRST REPORT	

FARM Lewis

LOC. C SE NW

GEOL. _____

CONTR. Musgrove tools

POOL Greenwood

SPUD _____

WIRT

CO. LSE. NO. SEC. TWP. RGE.

S-513-A

COMPLETED
MAR 27 1958

LOC. C ST. 12

GEOL.

CONTR. ~~MUS PROV. 10075~~

POOL Greenwood

SPUD 12-9-57

ST-201 04-1-81

724/350 ~~1550~~

~~3-2-1-2-3-4-5~~

DEC 26 57 DST 3146

-50 60" 9/5"

GA 274-117"

TD 3340

450 mcf / 60" - 280' 9" diam

FP 40-95 BHP 410/20"

05T 3174-3215 75" 9/27"

9a 589 mcf/30" 856 mcf/75"

20' g cm FP 280-360 BHP

430 20" TP 3346 ra log

4 3310/200 Co 3280

20/ 3247-52 20/ 3225-30

(1/2) testing JAN 2 '58 JAN 3 '58

2 JAN 22 58 JAN 22 58 JAN 22 58

LOG
Tops Krid 2111 Win 2189

Wab 2809 TP 3135 GW

Wab 2007 11 3135 G
Lsg 3317 16/ 3183-82

20/3170-75 16/3116-20

20/ 3170-73 16/ 316-10
20/ 3093-98 48/ 3070-82

20/3093-48 48/3010
59a2 Mac 30x159a

59 gas pipe 30x15 ga
10.900 mcs 16 hrs wotsts

10:400 mcf 16 hrs WOTSA
JAN 15 '58 WOTSA JAN 29 '58 FEB 12 '58

JAN 15 '58 60157 JAN 29 '58 FEB 12 '58 FEB 19 '58
MAR 12 '58 MAR 19 '58 APR 21 '58 DELIVER

3.852 m-1 SIP41A

3.852 mcf SIP410
PB3280

~~3070~~ 3070-30.52

~~3070~~ 3070-3252