


Section 18 Township 34 Range 13 <sup>W</sup><sub>11</sub>

Well No. #1 Blunk

Company Helmerich & Payne

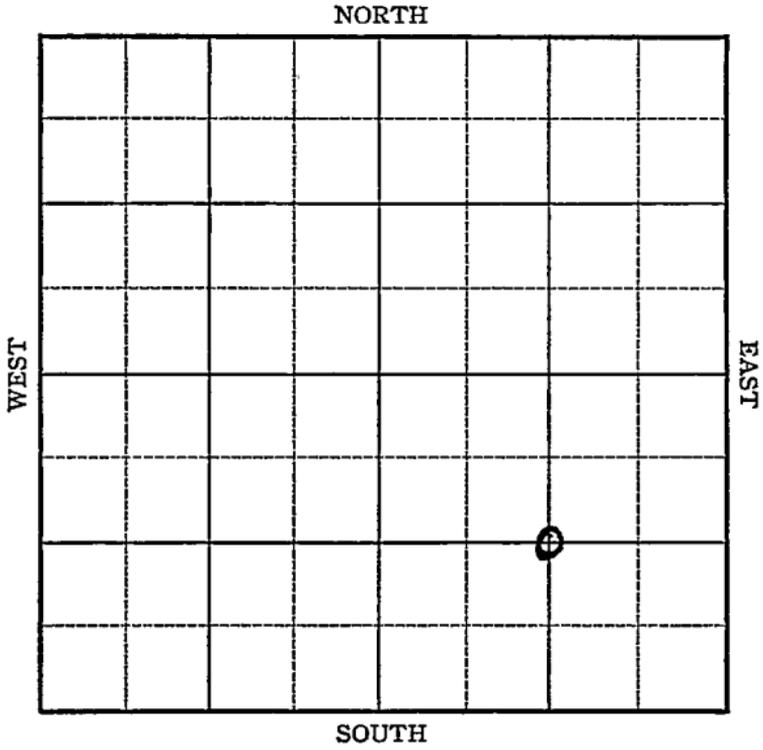

Sec. 18 Twp. 34 R. 13W

Well No. '1-Blunk' Farm \_\_\_\_\_

Helmerish Payne Company \_\_\_\_\_


\_\_\_\_\_ Ft. from N. Line

1320 Ft. from S. Line

1320 Ft. from E. Line

\_\_\_\_\_ Ft. from W. Line

Elev. 1669

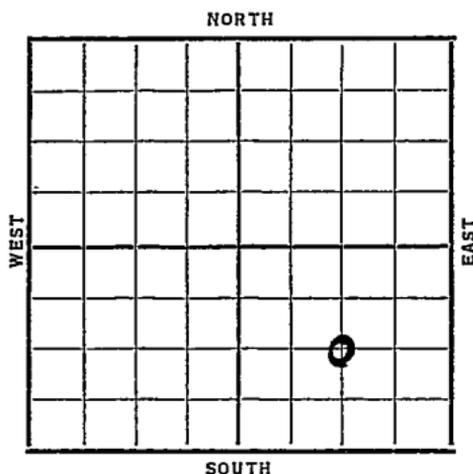

Date	REPORT
1937	
8/11	B.R.R.
8/20	15" @ 16'. WOC.
8/28	" " "
9/3	T.D. 219'. Rng. 10".
9/10	10" @ 219'. Drlg. 2410'.
9/17	Topeka 3275'? Drlg. 3385'.
9/24	Core 4087-94'. No shows.
	Drlg. 4155'.
10/1	Top Mississippi 4735--?
	Dlg. 4828 No show (Tel)
10/8	K.C. 3945'? Miss. 4735'.
	T.D. 4915'. No shows. SD.
10/15	Misner 5105'. Viola 5112'.
	Drlg. 5167'. No shows reported.
10/22	Simp. shale 5245'.
	T.D. 5253' SD.
	<b>OVER</b>

1937

10/27 Sil. 5384'.

T.D. 5405'.

**ABANDONED**

Map No. 93 Sec. 18 Twp. 34 R. 13<sup>w</sup>Well No. 1-BlunkHelmerich & Payne Company

Contractor

## FIRST REPORT

\_\_\_\_\_ Ft. from N. Line

1320 Ft. from S. Line1320 Ft. from E. Line

\_\_\_\_\_ Ft. from W. Line

## SECTION PLAT


Location \_\_\_\_\_

Rig up \_\_\_\_\_

Drilling and Remarks:

B.R.R.

## RECORD

Cased \_\_\_\_\_ in., \_\_\_\_\_ ft.

Sand \_\_\_\_\_

Gas \_\_\_\_\_

Oil \_\_\_\_\_

Total Depth \_\_\_\_\_

## PRODUCTION

\*1st 24 hrs. Nat. \_\_\_\_\_

1st 24 hrs. after shot \_\_\_\_\_

Gas \_\_\_\_\_ Cu. Ft.

Dry Hole \_\_\_\_\_

Abandoned \_\_\_\_\_

Date

AUG 11 1937H. D. Hatfield Scout

*no trace*

*Ray*

Returned	<i>Paul</i>
Cards	<i>Paul</i>
Tracing	<i>JP</i>
France Map	<i>X</i>
Scarborough Map	<i>X</i>
Moody Map	
Scarborough Plat Book	
Moody Plat Book	

Barber KANSAS

Map No. 93 Sec. 18 Twp. 34 R. 13W

Well No. 1 Blunk


Helmerich & Payne etal Company

Contractor

ABANDONED

SECTION PLAT

C SE

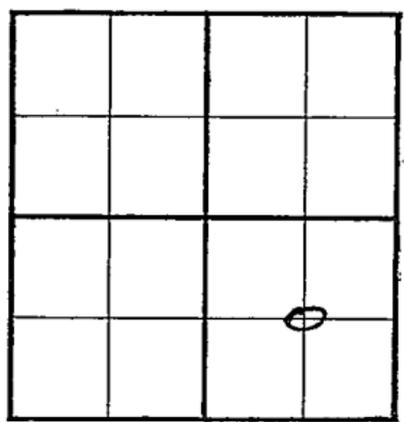

\_\_\_\_\_ Ft. from N. Line

1320 Ft. from S. Line

1320 Ft. from E. Line

\_\_\_\_\_ Ft. from W. Line

Location \_\_\_\_\_

Rig up \_\_\_\_\_

Drilling and Remarks:

*DVA*

RECORD

Cased \_\_\_\_\_ in., \_\_\_\_\_ ft.

Sand sil 5384

Gas \_\_\_\_\_

Oil \_\_\_\_\_

Total Depth 5405

PRODUCTION

1st 24 hrs. Nat. \_\_\_\_\_

1st 24 hrs. after shot \_\_\_\_\_

Gas \_\_\_\_\_ Cu. Ft.

Dry Hole \_\_\_\_\_

Abandoned \_\_\_\_\_

Date

OCT 27 1937

H. D. Hatfield

Scout

RAY

Returned	
Cards	<i>Paul</i>
Tracing	<i>Jim</i>
France Map	
