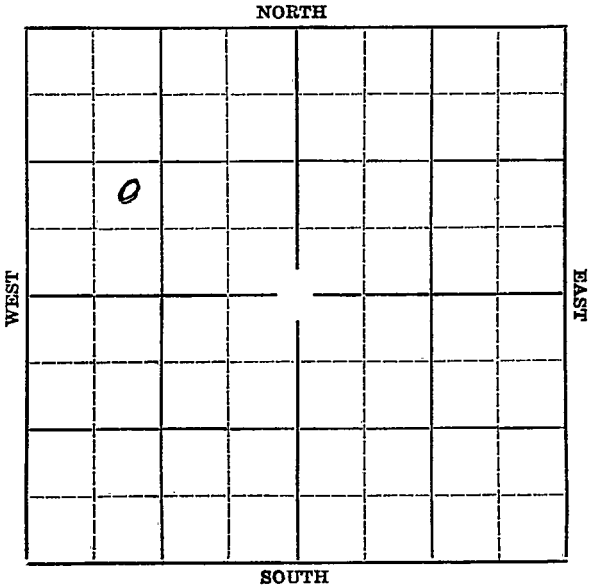
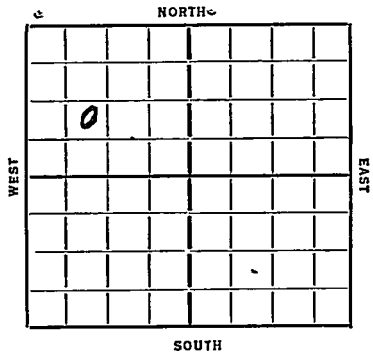


Section 18 Township 34 Range 14-WWell Number 2-DavisCompany W.I. Southern Oil

Form 252-A
5M 7-35 MPCMap No. KANSAS Sec. 18 Twp. 34 R. 14-WWell No. 2-Davis FarmW.I. Southern Oil Company Ft. from N. Line990 Ft. from S. Line Ft. from E. Line990 Ft. from W. Line

Elev. 1681

Date
1936

REPORT

4/15 Rig

4/23 -- 4/30 -- ~~3/27~~ --

5/7 Drlg. 375'.

5/14 --

5/21 Drlg. 3260'.

5/28 Drlg. 3720'.

6/4 Drlg. 4265'.

6/11 -- ~~6/18~~ --

6/18 Drlg. 4270'.

6/25 No report.

7/2 Miss. Lime. 4796'. T.D. 4840'.

7/9 60 qts. 4813-41'. 4 $\frac{3}{4}$ million cuft.
of gas. Drlg. 4980'.

7/16 Viola 5204'. Show oil 5210-22'.
T.D. 5226'. Shot 60 qts. No test.

7/23 Drlg. 5355'.

7/30 Simpson 5363'. Hole full of water 5
5401'. Plug back to 4950'.

OVER

8/5/36-Viola 5355'.

Hole full of water.

T.D. 5401'.

P.B. 4930'.

4-3/4 million cuft of gas.

COMPLETED

KANSAS

Map No. 93 Sec. 18 Twp. 34 R. 14WWell No. 2 MarieW. L. Southern Oil Company

Contractor

SECTION PLAT

0			

Ft. from N. Line

990 Ft. from S. Line

Ft. from E. Line

990 Ft. from W. Line

FIRST REPORT

Location

Rig up

Drilling and Remarks:

Rig

RECORD

Cased _____ in., _____ ft.

Sand _____

Gas _____

Oil _____

Total Depth _____

PRODUCTION

1st 24 hrs. Nat. _____

1st 24 hrs. after shot _____

Gas _____ Cu. Ft.

Dry Hole _____

Abandoned _____

Date

APR 15 1936

192

S. J. LEWIS

Scout

no use
small map
RDS

Returned	☒
Cards	☒
Tracing	☒
France Map	☒
Seaborough Map	☒
Moody Map	☒
Seaborough Plat Book	☒
Moody Plat Book	☒

KANSAS

Barber.
Map No. 93 Sec. 18 Twp. 34 R. 14WWell No. 2 DavisSouthern Oil Company

Contractor

SECTION PLAT

0			

 Ft. from N. Line990 Ft. from S. Line Ft. from E. Line990 Ft. from W. Line

COMPLETED

Location Rig up

Drilling and Remarks:

Viola 5385AFW 5401P.B 49804 3/4 M Gas.

RECORD

Cased in., ft.Sand Gas Oil Total Depth 5401

PRODUCTION

1st 24 hrs. Nat. 1st 24 hrs. after shot Gas Cu. Ft.Dry Hole Abandoned

Date

AUG 5 1936 19 S. J. LEWIS Scout

no wall map

[Signature]

Returned	<i>[Signature]</i>
Cards	<i>[Signature]</i>
Tracing	<i>[Signature]</i>
France Map	<i>[Signature]</i>
Scarborough Map	<i>[Signature]</i>
Moody Map	<i>[Signature]</i>
Scarborough Plot Book	
Leeds Plot Book	