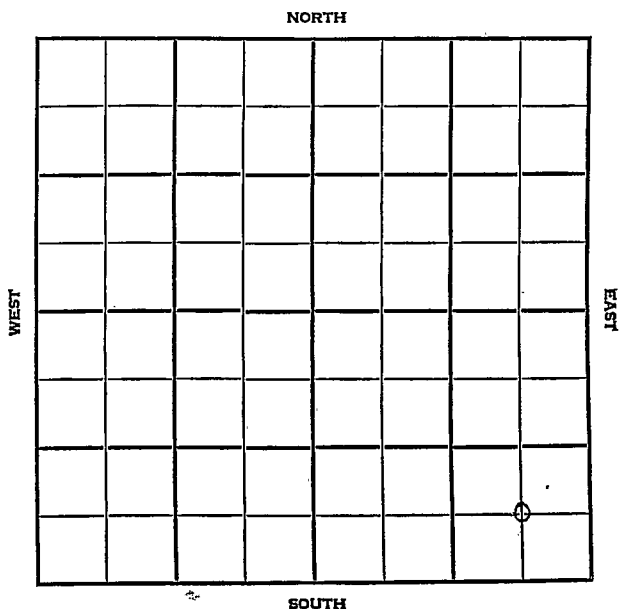


Section 18 Township 34 Range 16 WWell No. #1 Gates Ranch UnitCompany Sun Oil & Aladdin

Comanche

SEC.	TWP.	R.
18	34	16W

WELL NO.

#1 Gates Ranch Unit

FARM

COMPANY

Sun Oil & Aladdin

CONTRACTOR


_____ Ft. from N. Line

_____ Ft. from S. Line

_____ Ft. from E. Line

_____ Ft. from W. Line

C SE SE

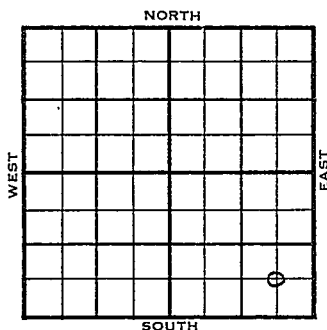

1955

ELEVATION

1795

REPORT

8/3

Comm 5-14-55

Tp 3394

H Elg 4016

Tr 4201

Dg 4274

L 4391

4394

M Ch 5094

5099

M 5131

K Warsaw 5270

V 5662

5664

Dolo 5838

5834

S 5873

5876

A 5980

5986

TD 6100

6101

13" @ 311/300 8 5/8" @ 2334/1100

DST 5097-5108 open 1 hr Rec 430 c/g

31' muddy oil 1660# DST 5150-80

open 1 hr Rec 20' mud S00 100/20"

DST 5873-89 open 25 min. Rec 820'

mud 20# 5 1/2" @ 5355/355 CO to

5285 36/5097-5106 500 A S/8 goph

frac 24/5104-10 frac 64/5260-76

S/35 gwph PB 5245 88/5176-98

SP 5165 S/8 gw 8 hr 2000 A

S/7 1/2 bwph

D & A

FIRST REPORT

ABANDONED

County Comanche Elev. 1795
 Sec. 18 Twp. 34 Rge. 16W
 Company Sun Oil & Aladdin
 Farm Name Gates Ranch Unit No. 1

TOPS	DEPTH	LOG	DATUM
Anh.			
Tp.	3394		1599
H. <u>E19</u>	4016		2221
Tr.	4201		2401
Dg.	4274		2479
Bl.			
L.	4391	4394	2599
K.C.			
B.K.C.			
Ce.			
C.			
M. <u>Ch</u>	5094	5099	3304
M.	5131		3336
K. <u>Warsaw</u>	5270		3475
Mz.			
Mo.			
V.	5662	5664	3869
S. <u>Dn 10</u>	5838	5834	4039
S.	5873	5876	4081
A	5980	5986	4191
R.			
Pe.			
G.			
T.D.	6100	6101	

Loc. in Sec. C SE SE

Geol.

Contr.

Pool Wildcat

REPORT			
ABANDONED			
			0

Date Comm. 5-14-55 AUG 3 1955

13" @ 311/300 8 5/8" @ 2334/1100

DST 5097-5108 open 1 hr. Rec. 430c/g

31' muddy oil 1660# DST 5150-800

open 1 hr. Rec. 20' mud SOO 100/20"

DST 5873-89 open 25 min. Rec. 820'

mud 20# 5 1/2" @ 5355/355 CO to 5285

36/ 5097-5106 500 A S/ 8 goph frac

24/ 5104-10 frac 64/ 5260-76

AUG 11 1955

Scout Cards	mm
Land Small Map	
Land Wall Map	
Tracings	
France Map	
Pierce Map	
Misc.	

S/ 35 gwpb PB 5245 88/ 5176-98
SP 5165 S/ 8 gw 8 hr. 2000 A
S/ 7 1/2 bwpb

D & A